

## WATER SERVICE RECORD

Name A. Raymond Carchia

Service No. 236 (1956)

Address 227 Grove Street # 2635

Location

Repair—Renewal—New Service

Comm. 4/1/57


Date	Material	Amount	Total	Date	Amount
8/22/56	Labor	4 10		8-8-56	Deposit # 75 00
	10% overhead	41	4 51	4-1-57	Refund 25 65
	76' 3/4" Copper tubing @.4850		36 86		NON CHARGE # 49 35
	1 3/4" C x 1/2 I.W.H. stop&waste		4 96		
	1 Hr. Trucking @ .75		75		Labor 2 05
	1 3/4" Union 3 part		2 27		23' 3/4" Copper tubing @.4850 11 16
			49 35		1 3/4" C Corp Cock 4 64
					1 3/4" C Curb Cock 5 94
					1 Box & Rod 4 62
					1 1/2 Straight tail piece 50
					1 1/2 Offset tail piece 50
					2 Hrs. Littlefield Shovel @ 8.50 17 00
					1 Hr. trucking @ .75 75
					47 16

DATE \_\_\_\_\_

**TOWN OF LEXINGTON — BOARD OF PUBLIC WORKS**

**WATER DIVISION**

Sketch of Service Here

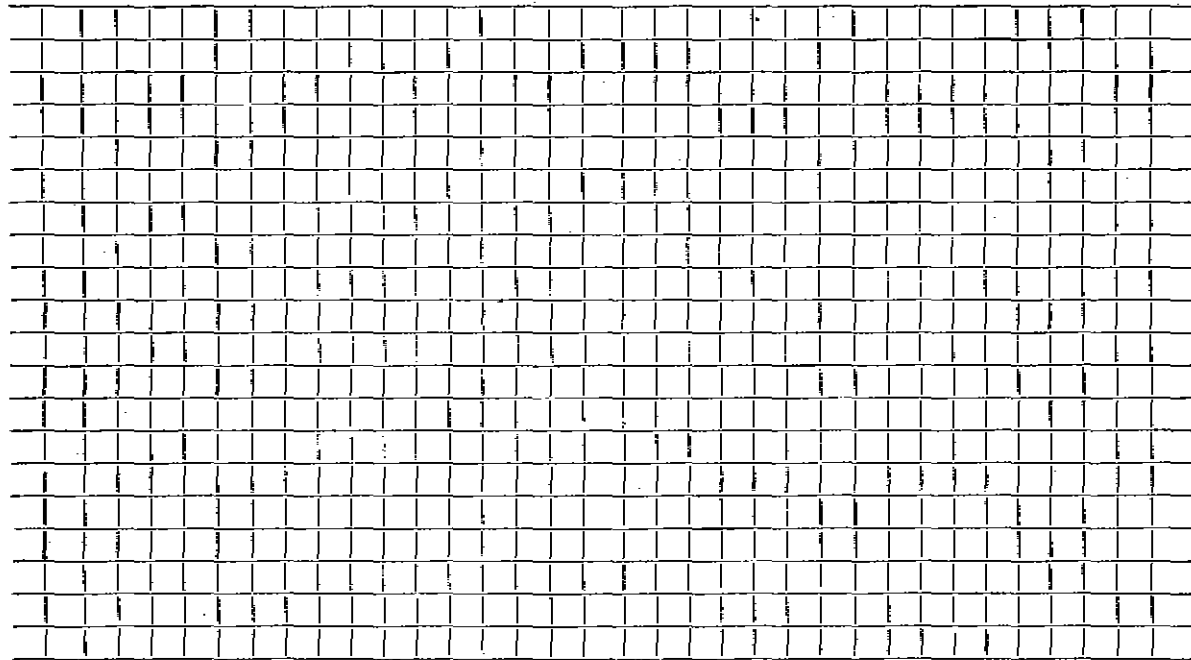

Connection made in ..... Street.      Work completed .....

Remarks: .....  
.....  
.....