

WATER SERVICE RECORD

Name S. Nielsen

Service No. 89

Address 232 Grove St.,

Location Lexington

Repair ~~Renewal~~ - New Service

*Com. 7-28-52*


Date	Material	Amount	Total	Date	Amount
6/3/52	Labor	1 63		5-15-52 Deposited	50 00
	10% Overhead	16	1 79	7-28-52 Refunded	18 56
	55' - 3/4" Copper tubing @.3439	18 91			31 45
	1 - 3/4" C x 1/2 I.W.H. Stop&Waste	4 00		6/3/52 Labor	10 13
	1 hr. trucking		75	15' - 3/4" Copper tubing @.3439	5 16
	patching 6 x 3		6 00	1 - 3/4" C. Corp. Cock	4 33
			31 45	1 - 3/4" C x 3/4" C. Curb-cock	4 67
				1 Box and Rod	4 52
				1 - 1/2 straight tail piece	50
	TRENCH DUG BY OWNER			1 - 1/2 offset tail piece	50
				3 hrs. Littlefield shovel	21 00
				1 hr. trucking	75
					51 56

DATE \_\_\_\_\_

TOWN OF LEXINGTON — BOARD OF PUBLIC WORKS

WATER DIVISION

Sketch of Service Here

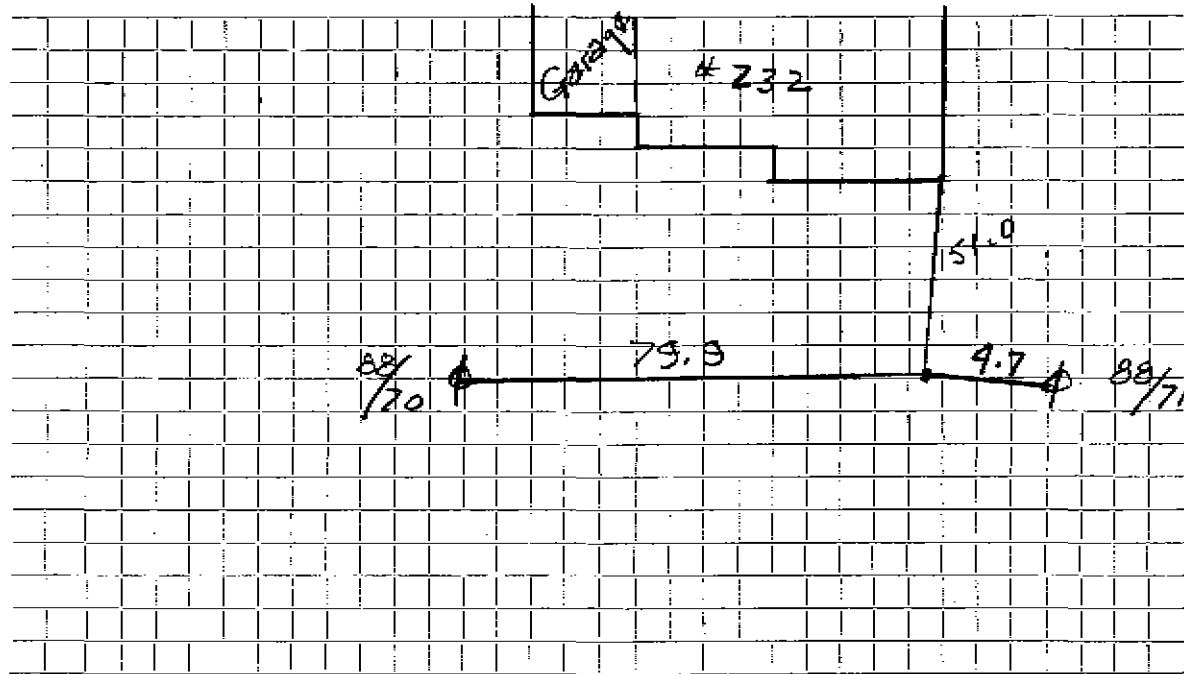

Connection made in ..... Street. Work completed .....

Remarks: .....

.....

.....