

WATER SERVICE RECORD

Name Herbert G. Johnson

Service No. 378

Address 240 Grove Street

# 2460

Location

Repair ~~Renewal~~ - New Service


Comm. 12-31-55

Date	Material	Amount	Total	Date	Amount
11/3/55	Labor	9 60		11-25-55 Deposited	100 00
11/5/55	"	11 09		12-31-55 Refunded	(29 69)
	10% Overhead	2 07	22 76		NON CHARGE
	75' - 3/4" Copper tubing @ .56		42 00	Labor	3 70
	1 - 3/4 Cx 1/2" I.W.H. Stop & Waste		4 00	10' 3/4" Copper tubing @ .56	5 60
	1 - 3/4 C. Union (3 parts)		1 72	1 - 3/4 C. Corp. Cock	4 33
	6 x 3 Patching		6 00	1 - 3/4 C. Curb Cock	4 67
	1 - 2/3 hrs. Littlefield Shovel @ 9.50		15 84	1 Box & rod	3 90
	1 hr. Trucking		75	1 - 1/2" straight tail piece	50
			70 31	1 - 1/2" offset tail piece	50
				1/3 hr. Littlefield Shovel @ 9.50	3 17
				1 hr. trucking	75
					27 12

DATE \_\_\_\_\_

TOWN OF LEXINGTON — BOARD OF PUBLIC WORKS  
WATER DIVISION

Sketch of Service Here

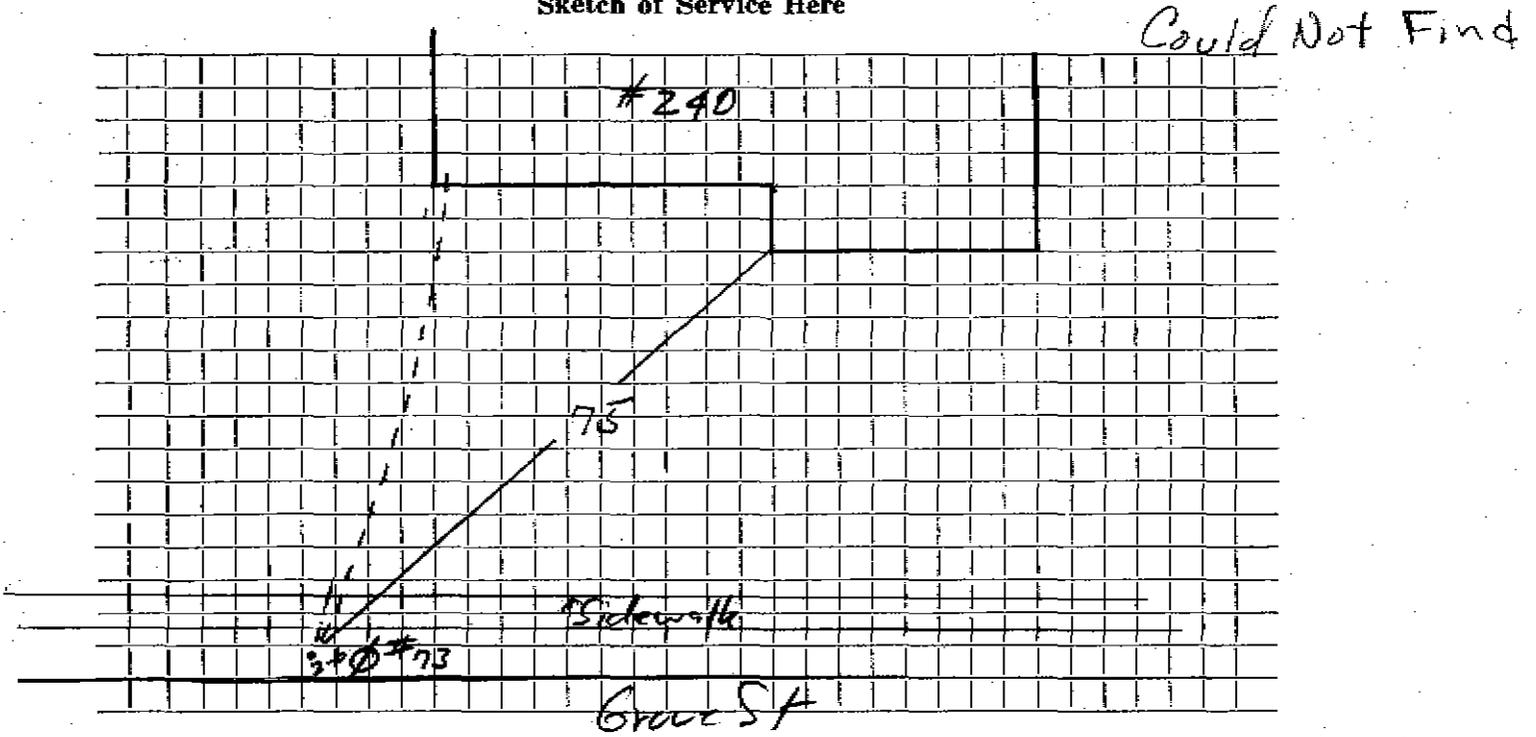

Connection made in ..... Street. Work completed .....

Remarks: .....  
.....  
.....