

WATER SERVICE RECORD

#3633

Name David Wilfert

Service No. 141

Address 242 Grove Street

Location Lexington

~~Repair - Remodel -~~ New Service

Com. 9-29-52


Date	Material	Amount	Total	Date	Amount
8/8/52	Labor	4 53		7-11-52	<i>Deposited</i>
	10% Overhead	45	4 98	9-29-52	<i>Refunded</i>
	60' - 3/4" Copper tubing @ .34		20 40		<u>NON CHARGE</u>
	1 - 3/4" C x 1/2 I.W. H. stop & waste	4 00		8/8/52	Labor
	3 hrs. Littlefield shovel		21 00		8' - 3/4" Copper tubing @ .34
	1 hr. trucking		75		1 - 3/4" C. Corp-cock
	patching 4 X 3		4 00		1 - 3/4" C x 3/4" C. Curb-cock
			55 13		1 Box and Rod
					1 - 1/2 offset tail piece
					1 - 1/2 straight tail piece
					1 hr. Littlefield shovel
					1 hr. trucking
					<u>28 90</u>

DATE _____

TOWN OF LEXINGTON — BOARD OF PUBLIC WORKS

WATER DIVISION

Sketch of Service Here

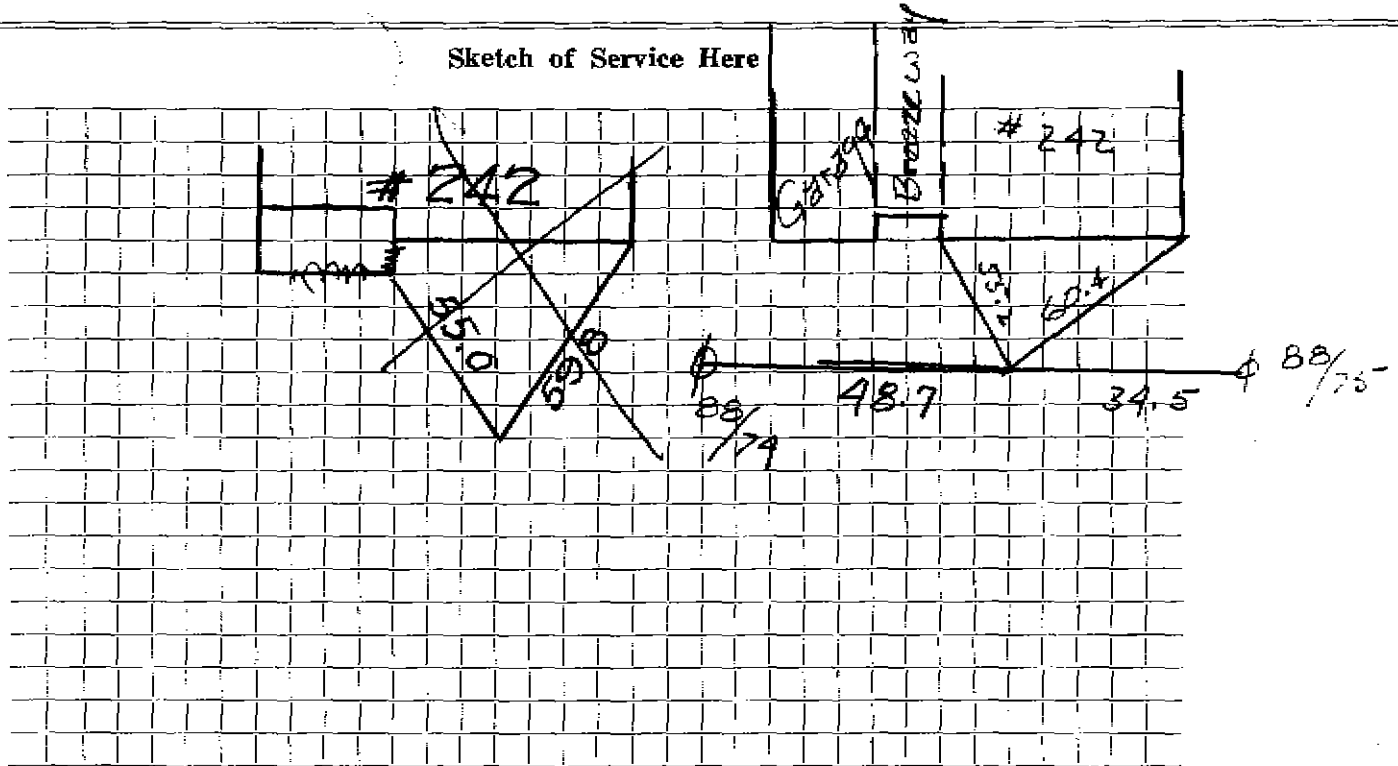

Connection made in _____ Street. Work completed _____

Remarks: _____
