

WATER SERVICE RECORD

3775

Name Charles Merrill

Service No. 159

Address 248 Grove Street

Location

Repair ~~Renewal~~ - New Service


Comm. 10-8-56

Date	Material	Amount	Total	Date	Amount
6/16/56	Labor	20 47		6-13-56	Deposit 125 00
	10% Overhead	2 05	22 52	10-8-56	Refund 33 67
	60' 3/4" Coppertubing @ .4850		29 10		91 33
	6 3/4 Cx 1/2 L.W.H. Stop & Waste		4 96		
	1 hr. trucking		75		NON CHARGE
	4 hrs. Littlefield @ 8.50		34 00		Labor 3 80
			91 33		9' 3/4" Coppertubing @ .4850 4 37
					1 3/4" C Corp Cock 4 64
					1 3/4" C Curb " 5 94
					1 Box & Rod 4 62
					1 1/2 Straight tail Piece 50
					1 1/2 Offset " " 50
					1 hr trucking 75
					2/3 hrs. Littlefield 8.50 5 66
					30 78

DATE _____

TOWN OF LEXINGTON — BOARD OF PUBLIC WORKS
WATER DIVISION

Sketch of Service Here

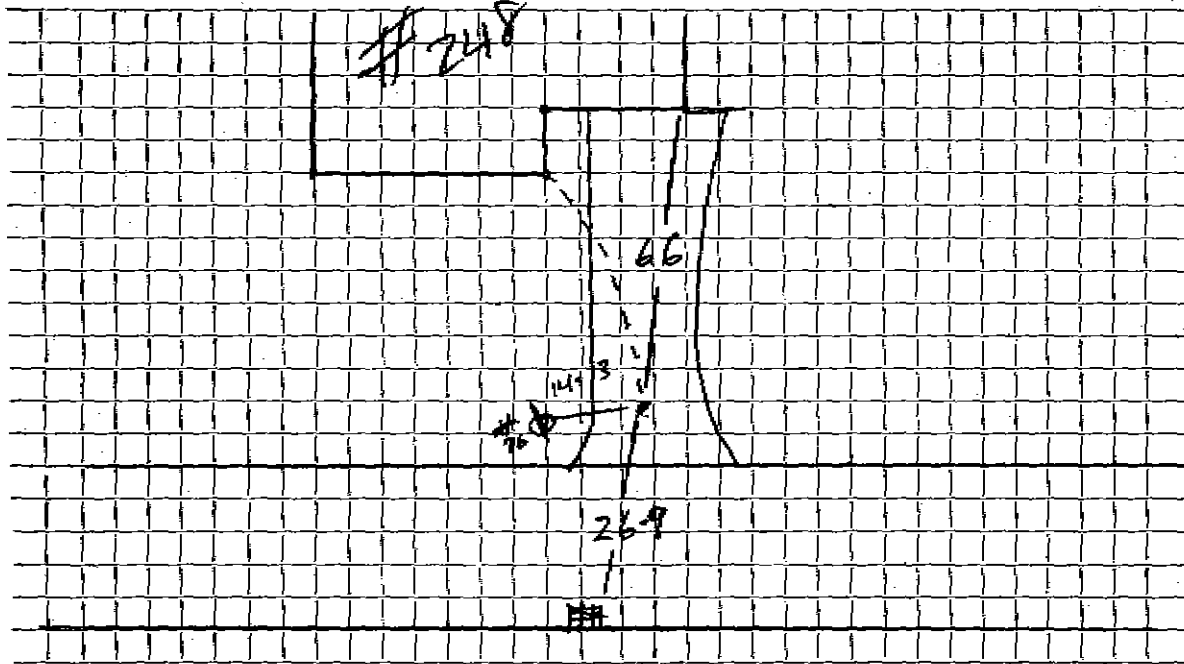

Connection made in Street. Work completed

Remarks:
.....
.....