


DATE 8-2-01

TOWN OF LEXINGTON — BOARD OF PUBLIC WORKS
WATER DIVISION

Sketch of Service Here

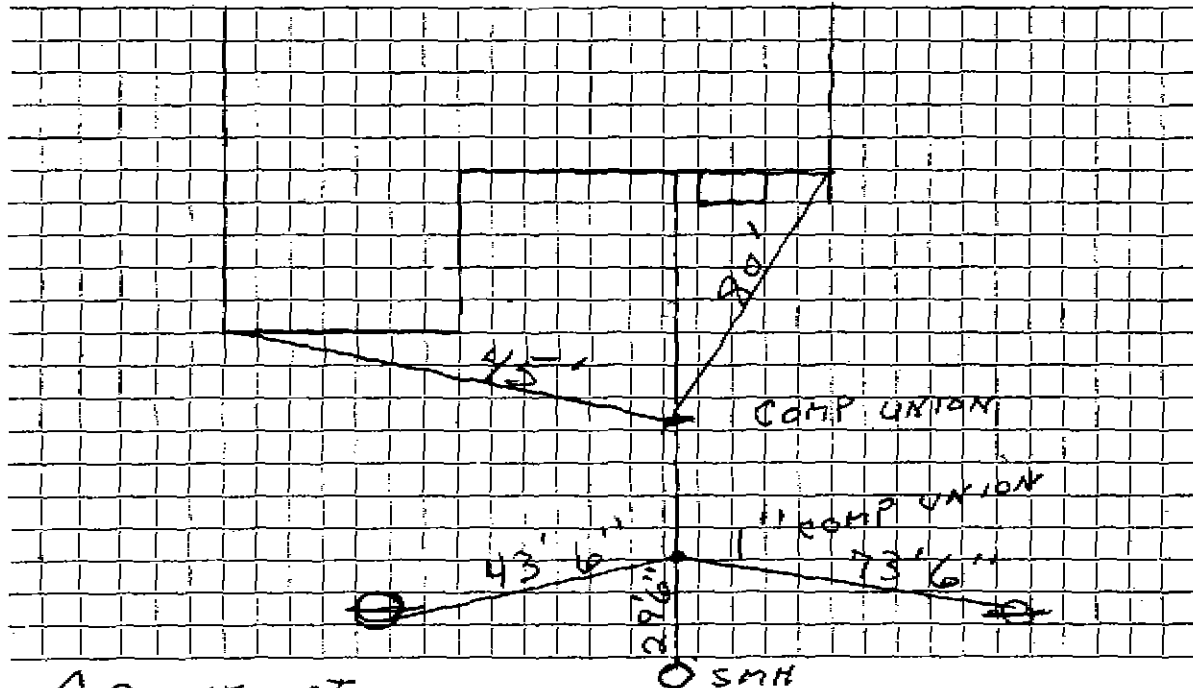

Connection made in GROVE ST. Street. Work completed

Remarks: INSTALLED BY TACCI CORP.