

WATER SERVICE RECORD

Name

Service No.

Address 37 GROVE ST.

Location

Repair—Renewal—New Service C.J. Parsons #91-10


Date		Amount	Total	Date	Amount
		OUTSIDE		IN	
9-23-	92	8 LF 1" COPPER			1" IRON
		1" COPPER BOX	BUFFALO BOX		
		1" CORP.			
7-13-	00	RENEW SERVICE	30' 1" COPPER		

DATE _____

TOWN OF LEXINGTON — BOARD OF PUBLIC WORKS

WATER DIVISION

Sketch of Service Here

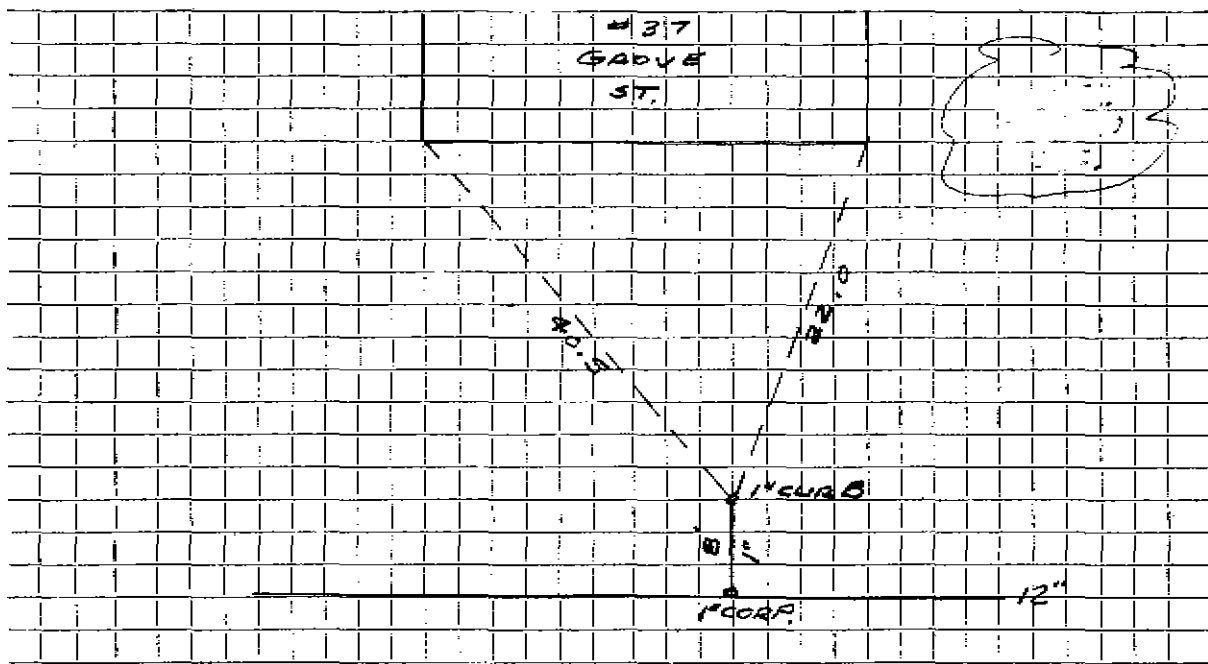

Connection made in GROVE Street. Work completed

Remarks: 1\" IRON INSIDE

.....

.....