


DATE 8/2/2017

TOWN OF LEXINGTON — BOARD OF PUBLIC WORKS

WATER DIVISION

Sketch of Service Here

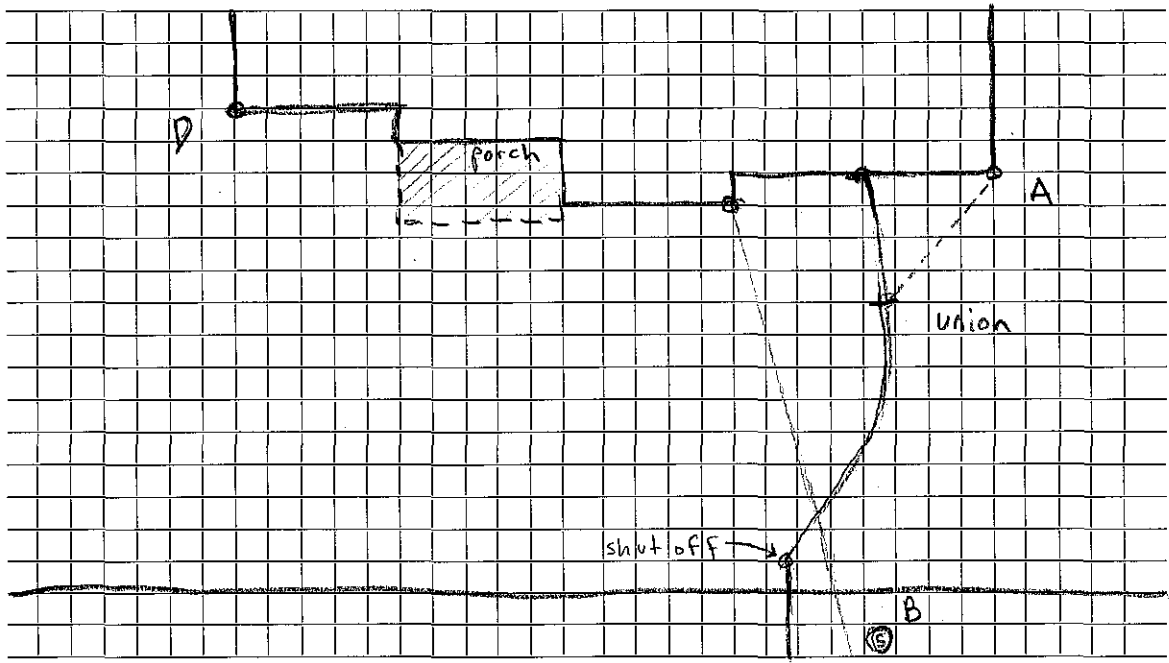

Connection made in 44 Grove Street Street. Work completed

Remarks: Water cutoff valve 5 foot depth

.....
.....