


DATE _____

TOWN OF LEXINGTON — BOARD OF PUBLIC WORKS

WATER DIVISION

Sketch of Service Here

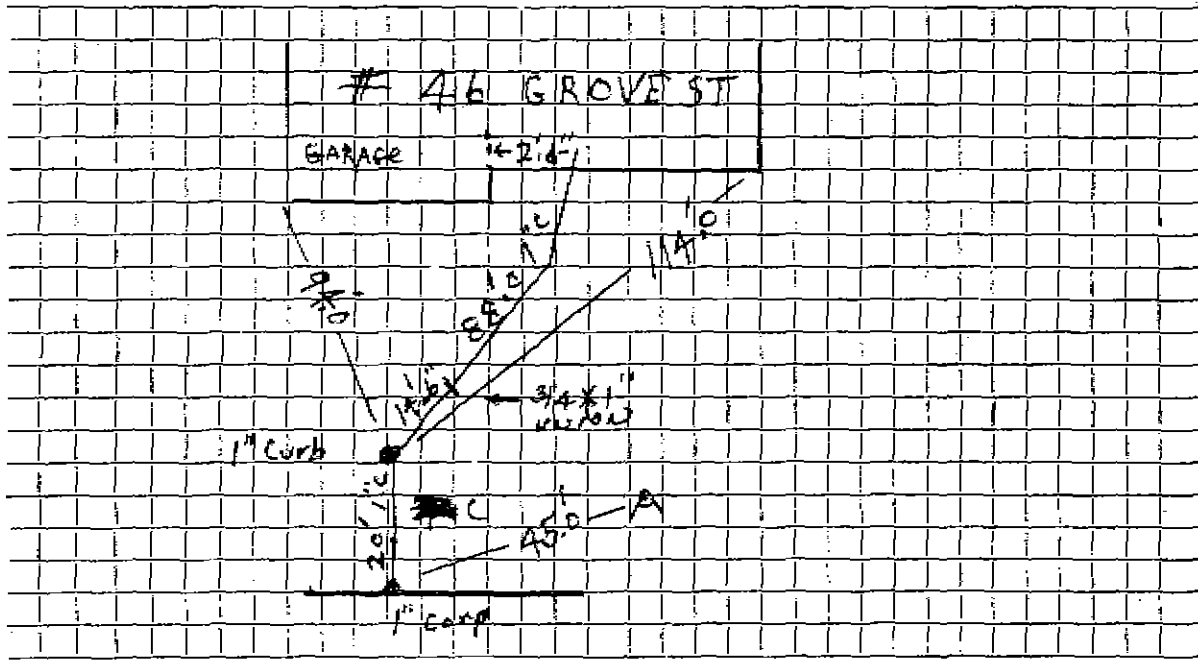

Connection made in Street. Work completed 12/11/04 J. McLaughlin

Remarks: INSIDE - NEW 1" Copper WAS CONNECTED TO EXIST. 3/4" Copper 19'6" FROM CURB STOP.