

WATER SERVICE RECORD

1294

Name Thomas Tuck

Service No. 99

Address 48 Grove St.,

Location Lexington, Mass.

Repair - ~~Renewal~~ - New Service

Com. 7-28-52


| Date | Material | Amount | Total | Date | Amount |
|---------|--------------------------------------|--------|-------|---------------------------------|-------------------|
| 6/13/52 | Labor | 3 02 | | 6-9-52 Deposited | 25 00 |
| | 10% Overhead | 30 | 3 32 | 7-28-52 Refunded | (17) 00 |
| | 60' - 3/4" Copper tubing@.3439 | 20 63 | | | <u>NON CHARGE</u> |
| | 1 - 3/4" C x 1/2 I.W.H. Stop & Waste | 4 00 | | 6/17/52 Labor | 9 06 |
| | 2 hrs. Littlefield shovel | 14 00 | | 80' - 3/4" Copper tubing@.3439 | 27 51 |
| | 1 hr. trucking | 75 | | 1 - 3/4" C. Core cock | 4 33 |
| | patching 15 X 3 | 15 00 | | 1 - 3/4" C x 3/4" C. Curb-cock | 4 67 |
| | | 57 70 | | 1 Box and Rod | 4 52 |
| | | | | 1 - 1/2 offset tail piece | 50 |
| | | | | 1 - 1/2 straight tail piece | 50 |
| | | | | 3 hrs. Littlefield shovel | 21 00 |
| | | | | 1 hr. trucking | 75 |
| | | | | 1 - 3/4" C x 3/4" C Union 3pts. | 1 72 |
| | | | | | 74 56 |

DATE _____

TOWN OF LEXINGTON — BOARD OF PUBLIC WORKS

WATER DIVISION

Sketch of Service Here

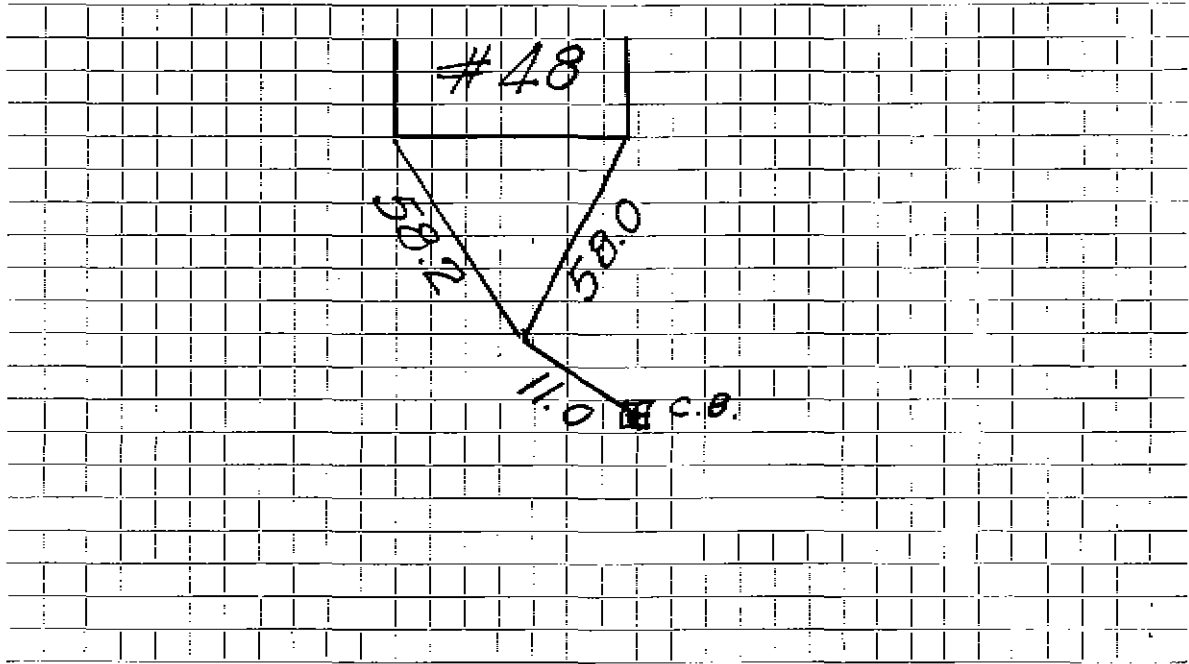

Connection made in Street. Work completed

Remarks:

.....

.....