

WATER SERVICE RECORD

Name Thomas Tuck

Service No. 100

267
362

Address 52 Grove Street

Location Lexington

~~Repair/Reconnect~~ New Service


Com. 7-28-52

Date	Material	Amount	Total	Date	Amount
6/13/52	Labor	3 02		6-2-52 7-28-52	75 00 <u>17 33</u>
	10% overhead	30	3 32		87 70
	60' - 3/4" copper tubing @ .3439	20 63			<u>NON CHARGE</u>
	1 - 3/4" C x 1/2 I.W.H. stop & waste	4 00		6/17/52	Labor 9 06
	2 hrs. Littlefield shovel		14 00		120' - 3/4" copper tubing @ .3439 41 26
	1 hr. trucking		75		1 - 3/4" C. corp-cock 4 33
	patching 15 x 3		15 00		1 - 3/4" C x 3/4" C. curb-cock 4 67
			57 70		1 box and rod 4 52
					1 - 3/4" C x 3/4" C. union 3 pts. 1 72
					1 - 1/2 offset tail piece 50
					1 - 1/2 straight tail piece 50
					3 hrs. Littlefield shovel @ 7.00 21 00
					1 hr. trucking 75
					<u>88 31</u>

TOWN OF LEXINGTON — BOARD OF PUBLIC WORKS

WATER DIVISION

Sketch of Service Here

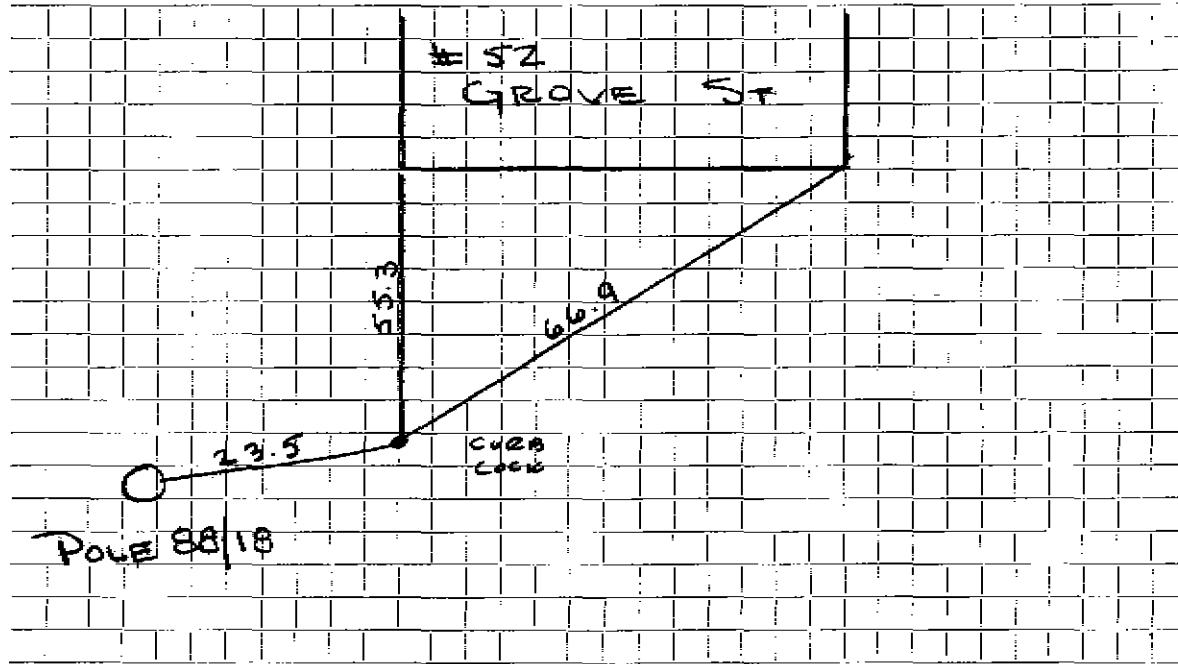

Connection made in Street. Work completed

Remarks:

.....

.....