

Name Paul Folsom

Service No.

3407

Address 71 Grove street

Location 71 Grove Street

Kind of Pipe

Size

Size of Main

~~Repair Overhead~~—New Service

Location

Date	Material	Amount	Total	Date	Amount	
Oct. 2, '47	Labor	18 21	18 21	Nov. 20 47	70 00	
	10% Overhead		1 82	Dec. 31 47	1 53	
	115' - 3/4" Copper Tubing @.26	29 90	29 90		68 47	
	1 - 3/4" C x 1/2" I.W.H. S' W	3 15	3 15	Oct. 2, '47	Labor	22 00
	2 - 3/4" C x 3/4" C U 3 pts.	2 64	2 64	19' - 3/4" Copper Tubing @.26	4 94	
	2 - hrs. Shovel @ 3.00	6 00	6 00	1 - 3/4" C Corp-cock	3 00	
	D 4 Tractor 2 hrs. @ 3.00	6 00	6 00	1 - 3/4" C x 3/4" C Curb-cock	3 68	
	Trucking 1 hr. @.75		75	1 - Box & Rod	4 26	
			68 47	1 - 1/2" Straight Tail Piece	30	
				1 - 1/2" Offset Tail Piece	30	
				Trucking 1 hr. @.75	75	
					39 23	
	Labor					

DATE \_\_\_\_\_

TOWN OF LEXINGTON - BOARD OF PUBLIC WORKS

**WATER DIVISION**

The undersigned applies for a supply of water at No..... St. and hereby agrees to comply with the rules and regulations as now, or at any future time, established by the Board of Selectmen.

Am't of Estimate \$.....

Owner .....


Am't Paid \$.....

Address .....

Builder .....

.....

Sketch of Service Here

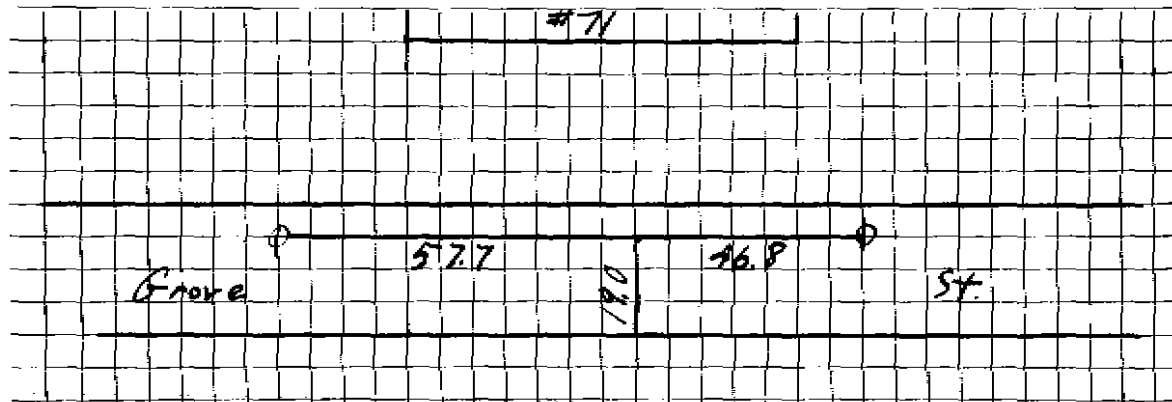

Connection made in ..... Street.

Work completed .....19

Remarks: