

**WATER SERVICE RECORD**

543

Name N. P. Neilson

**Service No.**

259

**Address** 91 Grove Street

**Location** Lexington, Mass.


## RENTAL RENEWAL—New Service

Date	Material	Amount	Total	Date		Amount
11/5/51	Labor	1 65	1 65	10/22/51	Deposited	21 00
	10% overhead		17	11/3/51	Refunded	(19 89)
	70' -5/4" copper tubing @ .326	22 82			NON CHARGE	55 11
	1 - 3/4" Cx1/2 I.W.H. stop & waste	4 00	11/2/51	Labor		3 30
	1 -3/4" Cx3/4" C.union (3pts.)	1 72	11/5/51			4 79
	1 hr. trucking	75	71' - 3/4" copper tubing @ .326	23 14		
	patching 24 x 3	24 00	1 - 3/4" C. corp-cock			4 33
		55 11	1 - 3/4" Cx3/4" C.union (3pt.)	1 72		
	TRENCH DUG BY OWNER		1 -3/4" Cx3/4" C.curb-cock			4 67
			1 box and rod			4 68
			1 - 1/2 offset tail piece			50
			1 - 1/2 straight tail piece			50
			5 hrs Littlefield shovel @ 7.00	35 00		
			1 hr. trucking			75
						83 38

DATE \_\_\_\_\_

TOWN OF LEXINGTON — BOARD OF PUBLIC WORKS  
WATER DIVISION

Sketch of Service Here

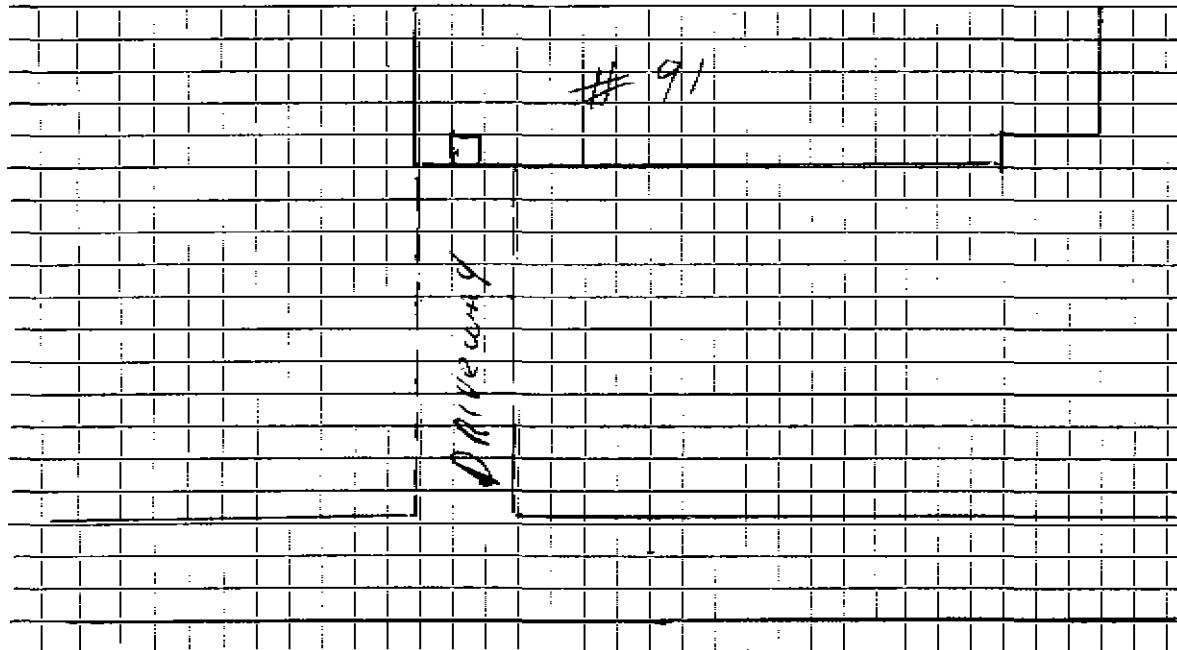

Connection made in ..... Street. Work completed .....

Remarks: .....