

WATER SERVICE RECORD

Name Joseph McDonough

Service No. 300

Address 91 Grove St.

Location Lexington

Repair: ~~Renewal~~ — New Service Com. 12-29-52


Date	Material	Amount	Total	Date	Amount
12/19/52	Labor	3 19		11-6-52 Deposited	50 00
	10% overhead	32	3 51	12-29-52 Refunded	(14 48)
	39' - 3/4" Copper Tubing @ .34	13 26			NOV-CHARGE
	1-3/4" Ox. I.W.F. Stop & Jesso	4 00		12/19/52 Labor	3 19
	2 Hr. Littlefield Shovel @ 7.00	14 00		17' - 3/4" Copper Tubing @ .34	5 78
	1 Hr. Trucking	75		1-3/4" C. Couer-cock	4 33
		35 52		1-3/4" C-3/4" C. Couer-cock	4 67
				1-Box & Rod	3 90
				1-3/8" Straight Tail Piece	50
				1-1/2" Offset Tail Piece	50
				1 Hr. Littlefield Shovel	7 00
				1 Hr. Trucking	75
					30 62

DATE _____

TOWN OF LEXINGTON — BOARD OF PUBLIC WORKS

WATER DIVISION

Sketch of Service Here

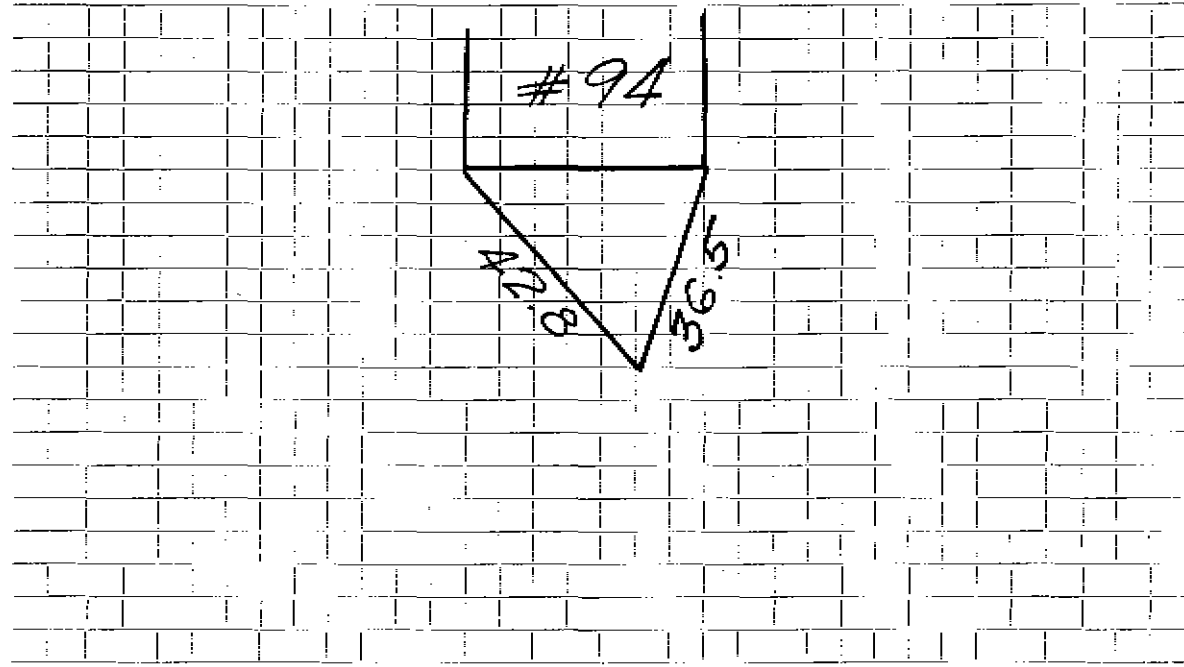

Connection made in Street. Work completed

Remarks:
.....
.....