

WATER SERVICE RECORD

Name Neils Neilsen

Service No. 23

Address 95 Grove Street

Location Lexington, Mass.

Repair: ~~General~~ - New Service


Com. 5-21-51

Date	Material	Amount	Total	Date	Amount
3-13-51	Labor	4 80	4 80	May 13 51	15 13
	10% Overhead		48	July 1 51	25 27
	82' - 3/4" Copper Tubing @.35	29 52			No Charge
	1 - 3/4" C x 1/2" I.W.H. S&W	4 00		3-13-51	Labor
	1 - 3/4" C x 3/4" C Union (3pts)	1 72			55' - 3/4" Copper Tubing @.35
	Littlefield Shovel 2 hrs. @7.00	14 00			1 - 3/4" C Corp-cock
	Trucking 1 hr. @.75		75		1 - 3/4" C x 3/4" C Curb-cock
	Patching 20 x 3		20 00		1 - Box & Rod
			75 27		1 - 3/8" Offset Tail Piece
					1 - 1/2" Straight Tail Piece
					Littlefield Shovel 2 hrs. @7.00
					Trucking 1 hr. @.75
					Rockwool 2 bags @ 1.38
					2 76
					61 99

DATE \_\_\_\_\_

**TOWN OF LEXINGTON — BOARD OF PUBLIC WORKS**  
**WATER DIVISION**

Sketch of Service Here

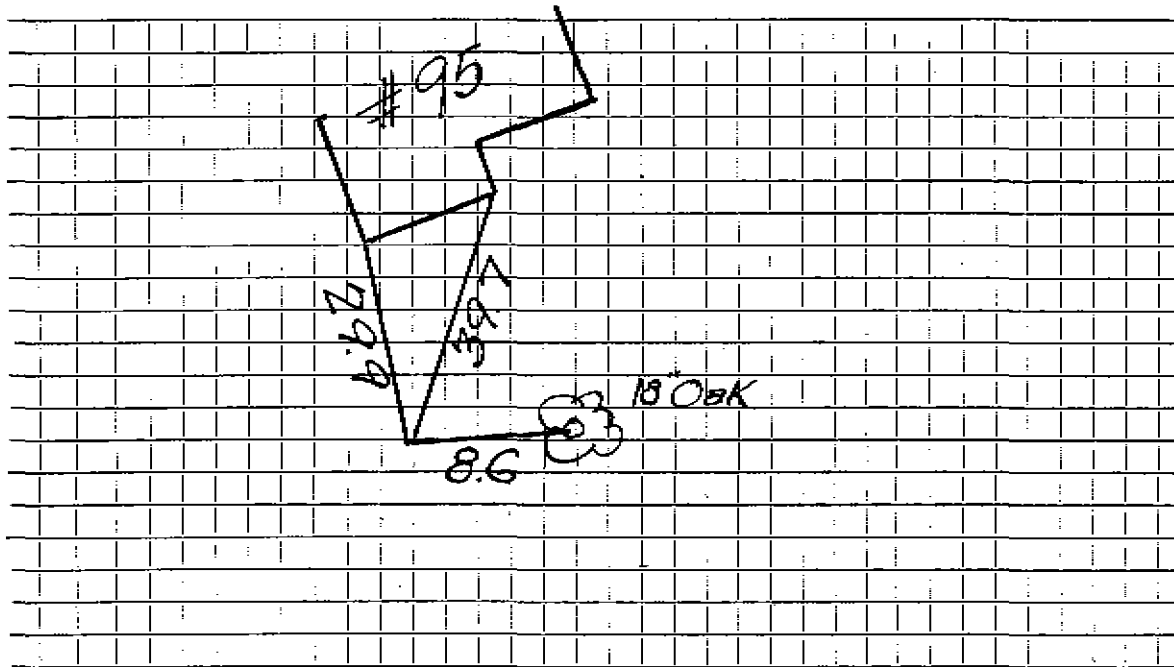

Connection made in ..... Street. Work completed .....

Remarks: .....

.....  
.....