

WATER SERVICE RECORD

Name John Wilfert

Service No. 185

Address 98 Grove Street

1705

Location Lexington

Repair ~~Renewal~~ New Service

Com 9-22-52


Date	Material	Amount	Total	Date	Amount
7/3/52	Labor	3 19		8-27-52	Deposited 50 00
	10% overhead	32	3 51	9-22-52	Refund. 11 28
	48' - 3/4" copper tubing@.3439	16 51			<u>NON CHARGE</u> 33 77
	1 - 3/4" C x 1/2 I.W.H. stop & waste	4 00		7/3/52	Labor 3 19
	2 hrs. Littlefield shovel	14 00			11' - 3/4" copper tubing@.3439 3 78
	1 hr. trucking		75		1 - 3/4" C. corp-cock 4 33
			38 77		1 - 3/4" C x 3/4" C. curb-cock 4 67
					1 - box and rod 3 90
					1 - 1/2 offset tail piece 50
					1 - 1/2 straight tail piece 50
					1 hr. Littlefield shovel 7 00
					1 hr. trucking 75
					<u>28 62</u>

DATE _____

TOWN OF LEXINGTON — BOARD OF PUBLIC WORKS

WATER DIVISION

Sketch of Service Here

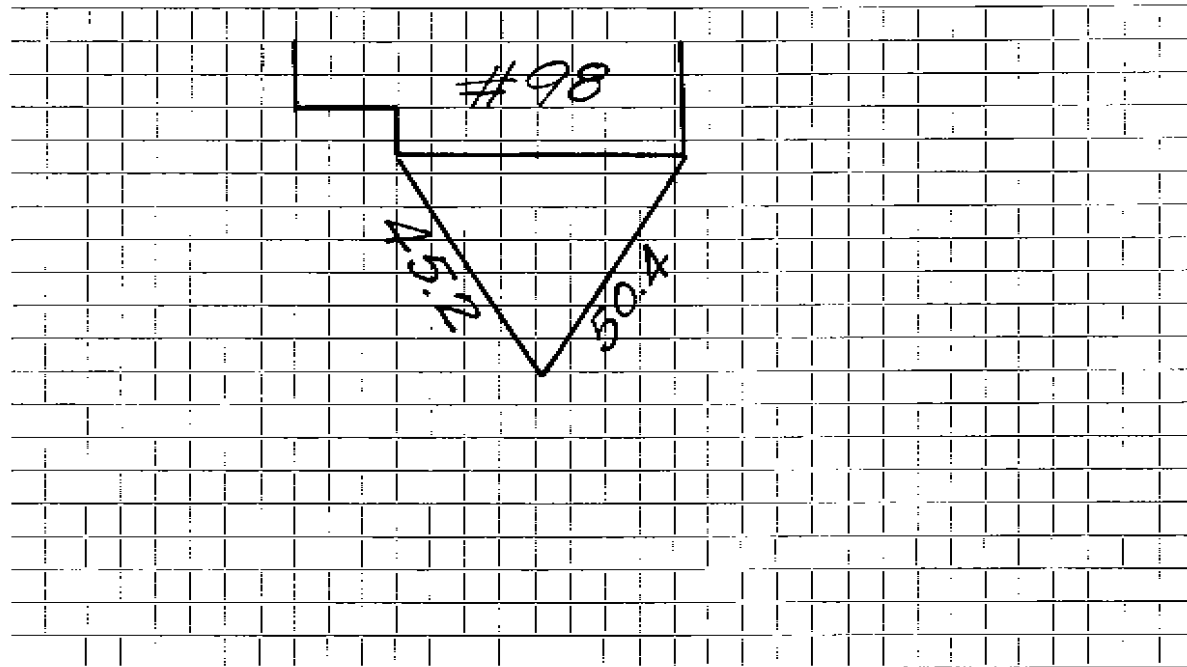

Connection made in Street. Work completed

Remarks:

.....

.....

8