

WATER SERVICE RECORD

Name

Service No.

Address 10 HADLEY RD

Location LOT 420 STA 6+82L

Repair—Renewal—New Service


Date	Material	Amount	Total	Date	Amount
6-16-67	79' 3/4 COPPER				60T
	2 3/4 UNIONS			12-3-90	20' 3/4 COPPER
					1 3/4 COPP.
					1 3/4 COMP UNIONS

DATE _____

TOWN OF LEXINGTON — BOARD OF PUBLIC WORKS

WATER DIVISION

Sketch of Service Here

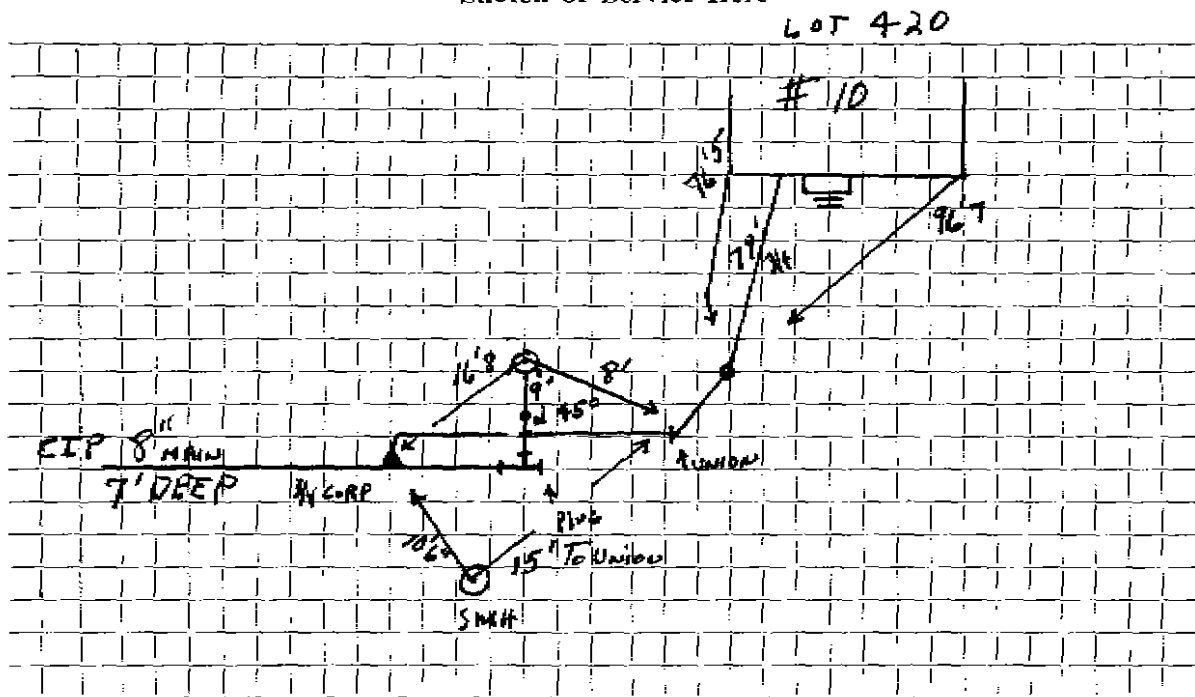

Connection made in _____ Street. Work completed _____

Remarks: 12' 5" - From Hyd. To Tee. 9' Hyd. To 45° WATER SERVICE IS UNDER SEWER SERVICE BY FENCE NEAR EDGE OF RD