

WATER SERVICE RECORD

Name James C. Shea

Service No. 297

Address 11 Hamblen Street

17581

Location

~~Repair~~—Renewal—~~NEW SERVICE~~

Comm 2-8-60


Date	Material	Amount	Total	Date	Amount
1-21-60	Labor	2 10		11-12-59	50 00
	10% O. H.	21	2 31	2-8-60	9 39
70'	3/4" Copper tubing @.42		29 40		46 64
1	3/4" C x 1/2 I.W.H. Stop & Waste	5	88		NON CHARGE
1	Hr. Trucking @.75		75	1-21-60	Labor
1	3/4" C 3 part Union	2	27		16' 3/4" Copper tubing @.42
			40 61		1 3/4" C Corp Cock
					1 3/4" C Curb Cock
					1 Box & Rod
					1 1/8" Straight Tailpiece
					1 1/2" Offset Tailpiece
					25 06

DATE _____

TOWN OF LEXINGTON — BOARD OF PUBLIC WORKS

WATER DIVISION

Sketch of Service Here
OFF OLD TIE CARD

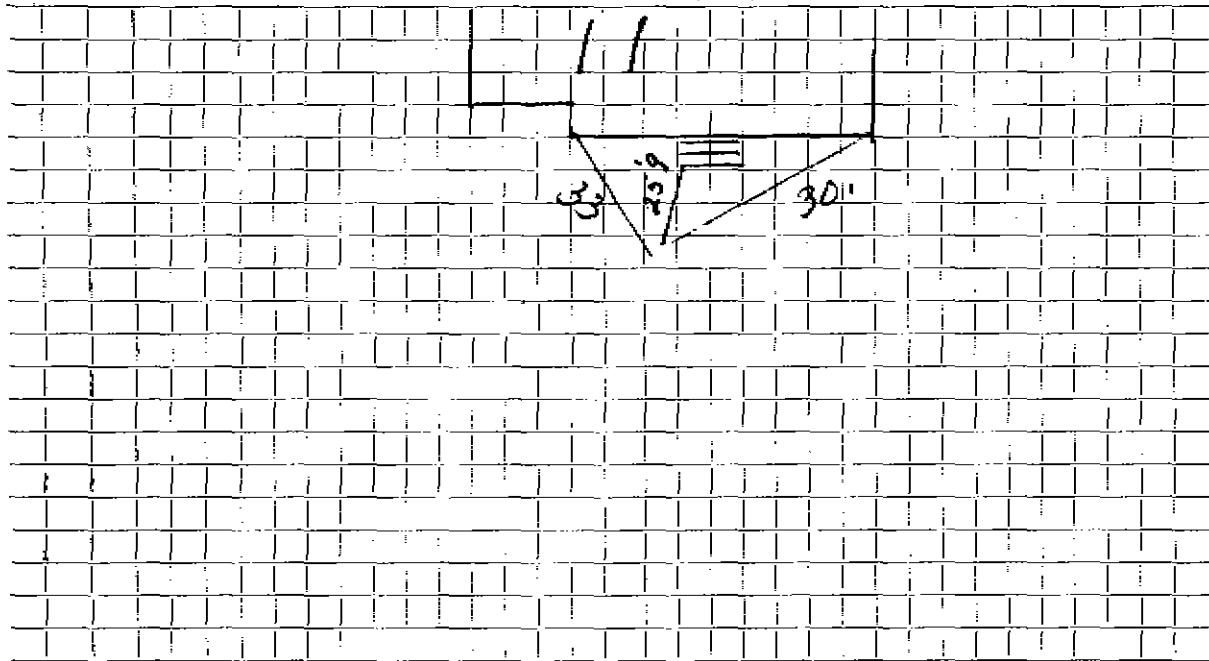

Connection made in Street. Work completed

Remarks:

.....

.....