




DATE \_\_\_\_\_

TOWN OF LEXINGTON — BOARD OF PUBLIC WORKS

WATER DIVISION

Sketch of Service Here  
TIE off old CARD

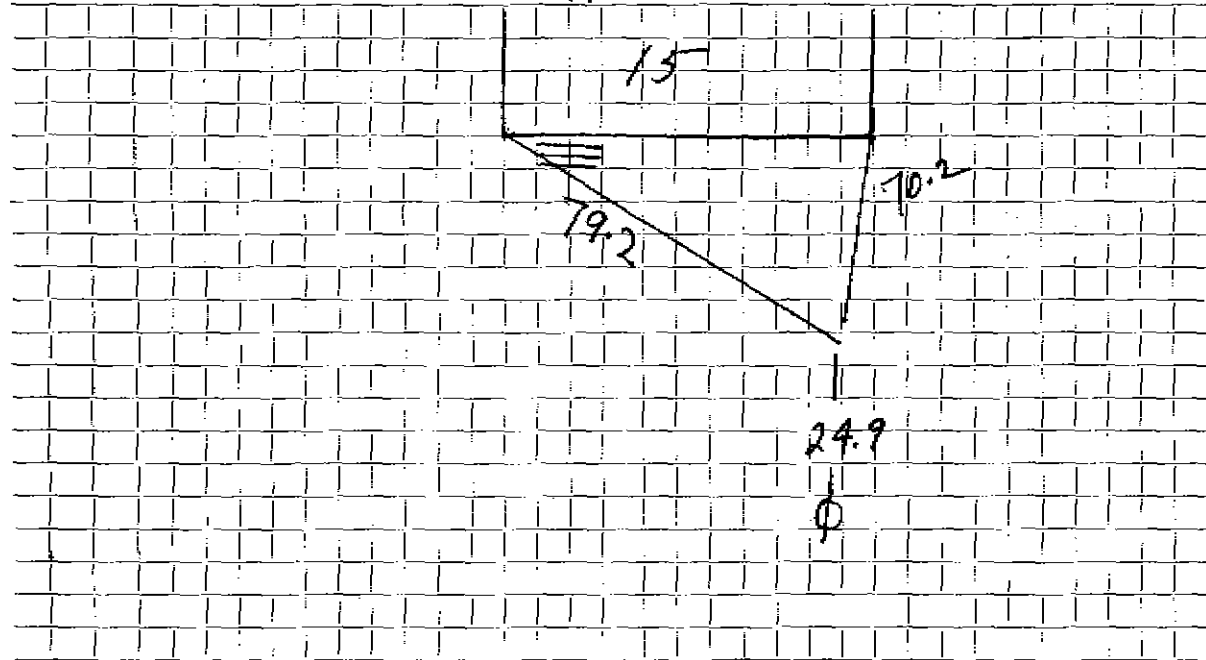

Connection made in ..... Street. Work completed .....

Remarks: .....

.....  
.....




DATE \_\_\_\_\_

TOWN OF LEXINGTON — BOARD OF PUBLIC WORKS

**WATER DIVISION**

Sketch of Service Here

#15 Hambley

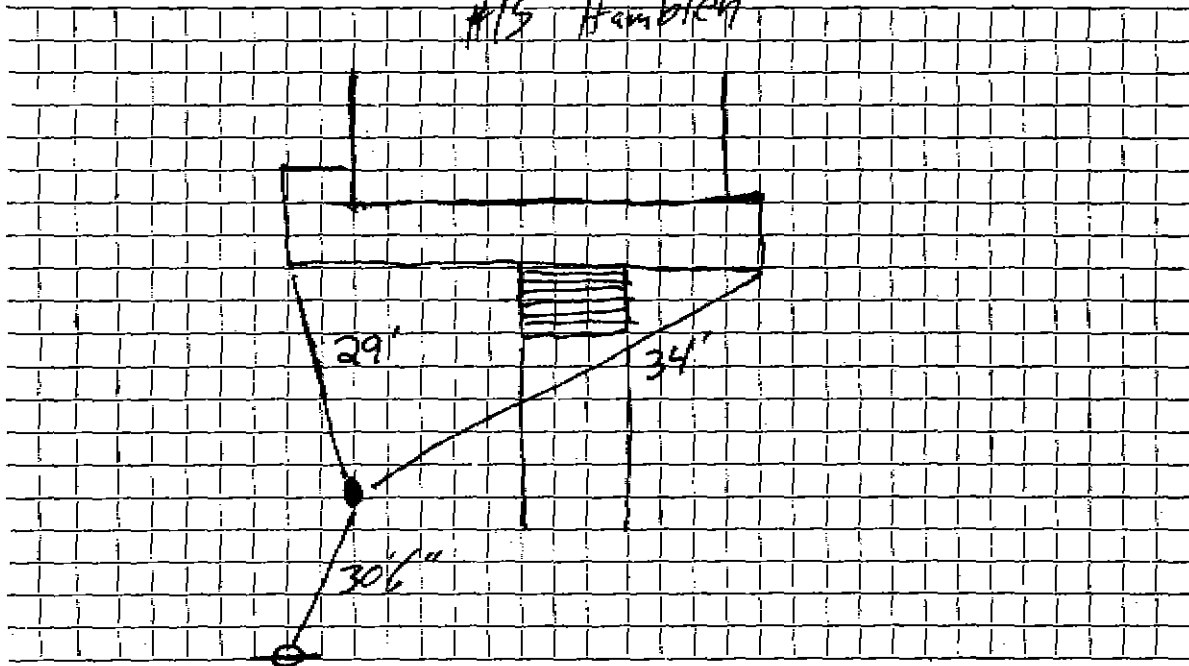

Connection made in ..... Street. Work completed .....

Remarks: .....

.....

.....