

## WATER SERVICE RECORD

1195

Name Leo P. McCabe

Service No. 227

Address 17 Hamblin Street

Location

~~Repair or Renewal~~ — New Service*Can 11-30-59*

Date	Material	Amount	Total	Date		Amount
9-17-59	Labor	3.86		7-14-59	Repair	38.00
	10% O.H.	.39	4.25	11-30-59	* Retained	23.54
	38' 3/4" Copper tubing	.41	15.58			26.76
	1 3/4" C x 1/2 I.W.B. Stopwaste		5.88			
	1 Hr. Truckings	.75	.75			
			28.46			
					NON CHARGE	
					Labor	3.86
					12' 3/4" Copper tubing @	4.92
					1 3/4" C Corp Cock	4.67
					1 3/4" E Curb Cock	5.98
					1 Box&rod	5.00
					1 1/2 Straight tailpiece	.50
					1 1/2 Offset tailpiece	.50
						25.43


*\* Applied to SM# 123 (28.73)*

DATE \_\_\_\_\_

TOWN OF LEXINGTON — BOARD OF PUBLIC WORKS

**WATER DIVISION**

Sketch of Service Here

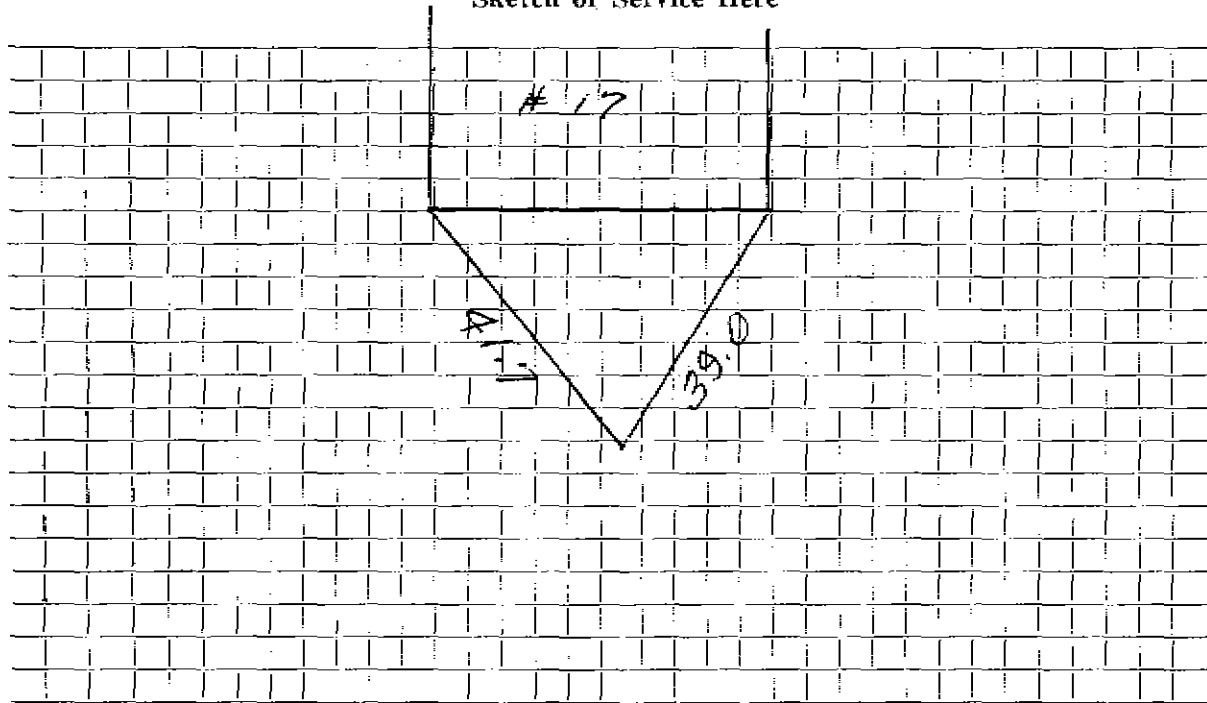

Connection made in ..... Street. Work completed .....

Remarks: .....

.....

.....