

WATER SERVICE RECORD

Name Fred J. Kolb

Service No. 232

Address 18 Hamblin Street

Location

~~Remainder of~~ New Service

Paid 11-3-59


Date	Material	Amount	Total	Date	Amount	
9-25-59	Labor	1.85		9-16-59	Deposit	25.00
	10% O.H.	.19	2.04	11-30-59	Paid by S.M. # 178	1.66
60'	3/4" Copper tubing @.41		24.60	12-14-59	Paid	6.61
1	3/4" C x 1/2 I.W.H. Stop & Waste		5.88		NON CHARGE	33.27
1	hr. Trucking @.75		.75		Labor	1.85
			33.27	24'	3/4" Copper tubing @.41	9.84
				1	3/4" C Corp Cock	4.67
				1	3/4" C Curb Cock	5.98
				1	box & rod	5.00
				1	1/2 Straight tailpiece	.50
				1	1/2 Offset tailpiece	.50
						28.34

DATE _____

TOWN OF LEXINGTON — BOARD OF PUBLIC WORKS

WATER DIVISION

Sketch of Service Here

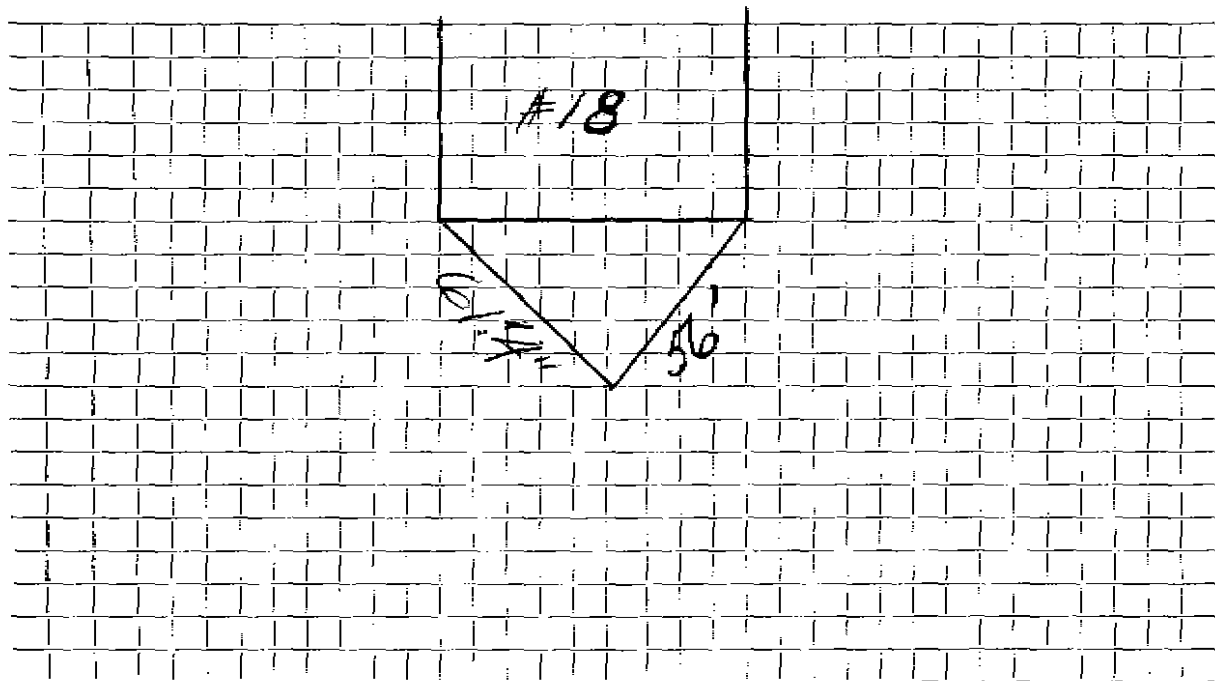

Connection made in Street. Work completed

Remarks:

.....

.....