

WATER SERVICE RECORD

PERMIT
Service No. 1560

Name

Address

7 HAMBLYN Rd

Location

Repair—Renewal—New Service


Date	Material	Amount	Total	Date	OUTSIDE	Amount
4-6-01	1" COPPER			4-6		
				6-9-44	2'-3/4" COPPER	
					1-1" CURB	
					1-3/4" X 1" INCREASER	

DATE 4-6-2001

TOWN OF LEXINGTON — BOARD OF PUBLIC WORKS

WATER DIVISION

Sketch of Service Here

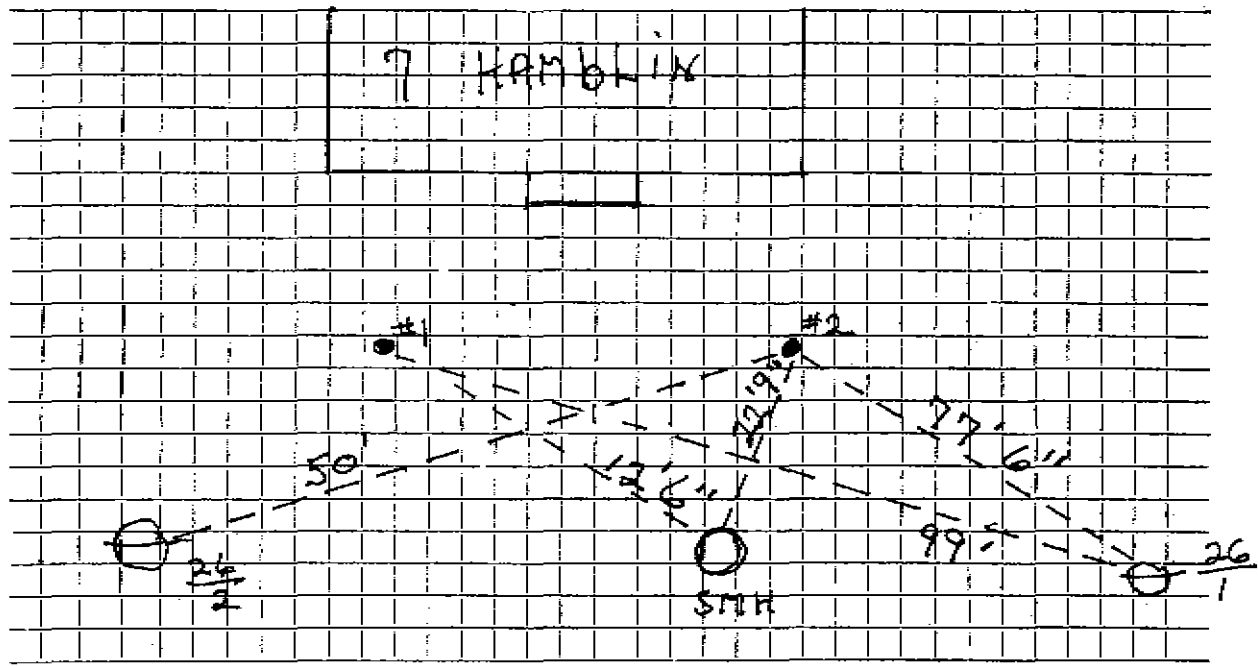

Connection made in HAMBLIN ST Street. Work completed 4-10-2001

Remarks: INSTALLED BY CHARLES TODD CO.
TWO SERVICES OFF STREET.