

Name E. B. Hamilton
 Address 17 Hamilton Road
 Lexington, Mass.

Service No. 71 3172
 #1547

Location 17 Hamilton Road

Kind of Pipe

Size

Size of Main

~~Repair - Renewal~~ New Service

Com 12-30-46

Location

Date	Material	Amount	Total	Date	Amount
Oct. 18, '46	Labor	1 80	1 80	<i>Aug 9, '46</i>	<i>Deposited</i>
	10% Overhead		18	<i>to 11/16</i>	<i>Deposited</i>
	27' - $\frac{3}{4}$ " Copper Tubing @.23	6 21			Non-Charge
	1 - $\frac{3}{4}$ " C x $\frac{1}{2}$ " I.W.H. S. & W.	2 82		Aug. 28, '46	Labor
	1 - $\frac{3}{4}$ " C x $\frac{3}{4}$ " C Union (3 parts)	1 32			30' - $\frac{3}{4}$ " Copper Tubing @.23
	Trucking 1 hr. @.75		75		1 - $\frac{3}{4}$ " C Corp-cock
			13 08		1 - $\frac{3}{4}$ " C x $\frac{3}{4}$ " C Curb-cock
	<u>Trench dug by Owner</u>				1 - Box & Rod
					1 - $\frac{1}{2}$ " Straight Tail Piece
					1 - $\frac{1}{2}$ " Offset Tail Piece
					Trucking 1 hr. @.75
	Labor				<u>75</u>
					38 28

Hawley Press, Inc., Lexington

DATE _____

TOWN OF LEXINGTON - BOARD OF PUBLIC WORKS

WATER DIVISION

The undersigned applies for a supply of water at No. _____ St. and hereby agrees to comply with the rules and regulations as now, or at any future time, established by the Board of Selectmen.


Am't. of Estimate \$ _____

Owner _____

Am't. Paid \$ _____

Address _____

Builder _____

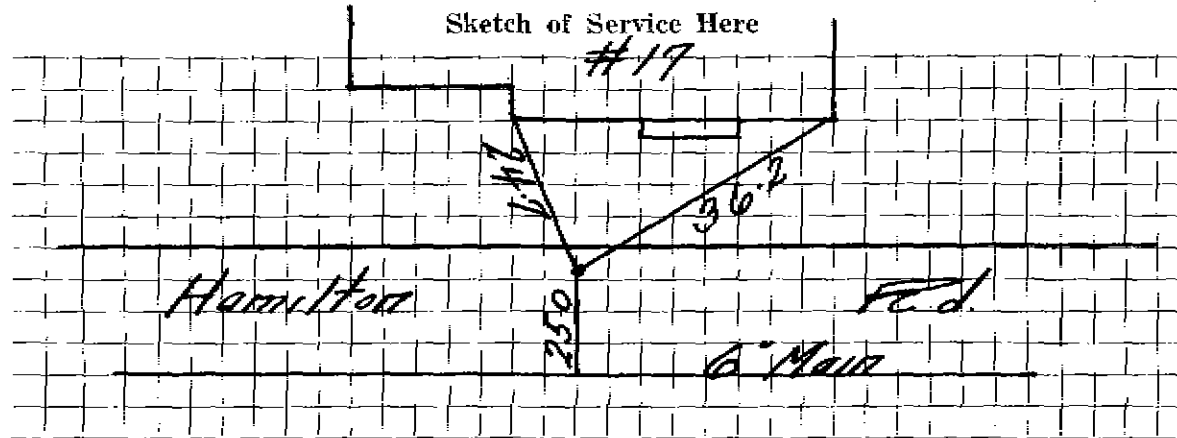

Connection made in _____ Street.

Work completed _____ 19

Remarks: