

Name Eugene B. Hamilton

1443

Service No. 29 3121

Address 23 Powder House Terrace

West Somerville, Mass.

Location 18 Hamilton Road

Kind of Pipe

Size

Size of Main

Repair ~~Renewal~~ — New Service

Com 9-16-46

Location

Date	Material	Amount	Total	Date	Location	Amount
May 10, '46	Labor	90	90	May 10 '46	<i>Deposited</i>	15 00
	10% Overhead		09	Sept 19 '46		5 5
	29' - 3/4" Copper Tubing @ .1815	5 26			Non-Charge	9 82
	1 - 3/8" c x 2" I.Y. Stop & Waste	2 82		May 10, '46	Labor	10 00
	Trucking 1 hr. @ .75	0 75	75	14' - 3/4" Copper Tubing @ .1815		2 54
			9 32	1 - 3/8" C. Corp-cock		2 70
				1 - 3/8" C. x 3/8" C. Corp-cock		3 30
				1 Box & Rod		1 65
				1 - 3/8" Straight Tail Piece		90
				1 - 3/8" Offset Tail Piece		90
				Trucking 1 hr. @ .75		75
						22 74
	Labor					

DATE _____

TOWN OF LEXINGTON—BOARD OF PUBLIC WORKS

WATER DIVISION

The undersigned applies for a supply of water at No. _____ St. and hereby agrees to comply with the rules and regulations as now, or at any future time, established by the Board of Selectmen.


Am't. of Estimate \$ _____

Owner _____

Am't. Paid \$ _____

Address _____

Builder _____

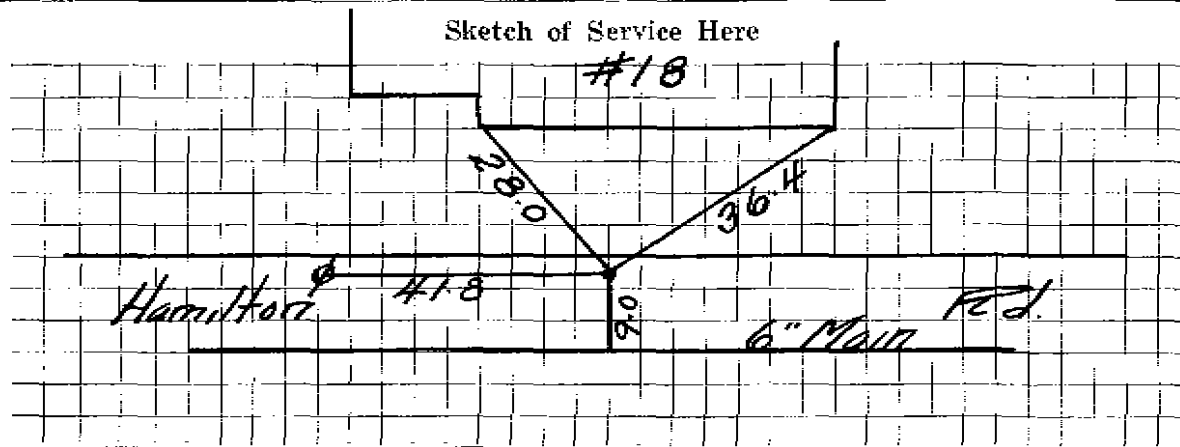

Connection made in _____ Street.

Work completed _____ 19

Remarks: