

Name E. B. Hamilton
 Address 21 Hamilton Road
 Lexington, Mass.

Service No. 57 3166
 # 4282
 # 7544

Location 21 Hamilton Road

Kind of Pipe

Size

Size of Main

~~Repair - Renewal~~ - New Service

Com 12-16-46

Location

Date	Material	Amount	Total	Date	Amount
Oct. 12, '46	Labor	1 80	1 80	Jul. 8 '46	15 00
	10% Overhead		18		
	38' - 1/2" Copper Tubing @.23	8 23	8 74		
	1 - 1/2" C x 1/2" I.W.H. S. & W.	2 82	2 82	Jul. 29, '46	16 14
	1 - 1/2" C x 1/2" C Union (3 parts)	1 32	1 32	28' - 1/2" Copper Tubing @.23	6 44
	Trucking 1 hr. @.75	75	75	1 - 1/2" C Corp-cock	2 70
			15 61	1 - 1/2" C x 1/2" C. Curb-cock	3 30
				1 - Box & Rod	3 30
				1 - 1/2" Straight Tail Piece	50
				1 - 1/2" Offset Tail Piece	50
				Trucking 1 hr. @.75	75
					33 63
	Labor				

No additional bill sent
French Dug By Owner

Deposited

No-Charge

Hadley Press, Inc., Lexington

TOWN OF LEXINGTON—BOARD OF PUBLIC WORKS WATER DIVISION

The undersigned applies for a supply of water at No. _____ St. and hereby agrees to comply with the rules and regulations as now, or at any future time, established by the Board of Selectmen.


Am't. of Estimate \$ _____

Owner _____

Am't. Paid \$ _____

Address _____

Builder _____

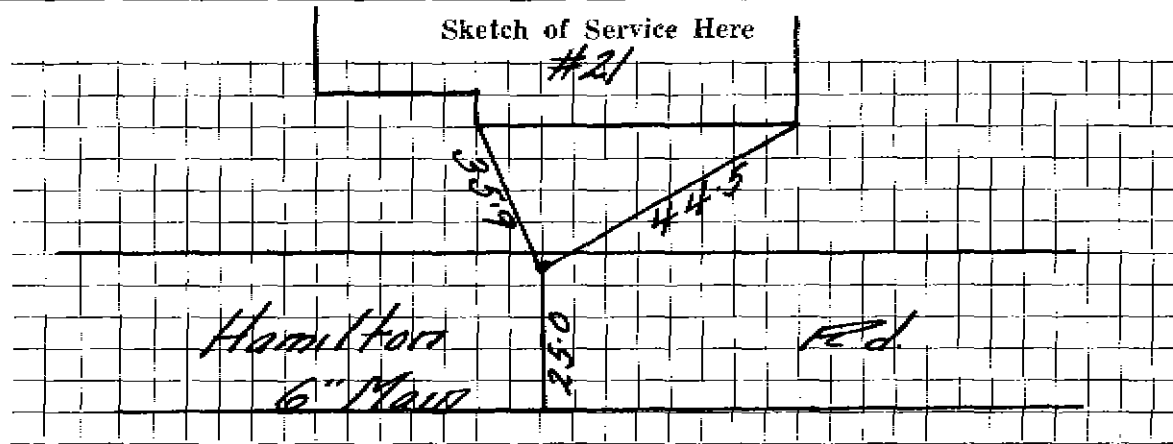

Connection made in _____ Street.

Work completed _____ 19

Remarks: