




DATE \_\_\_\_\_

TOWN OF LEXINGTON — BOARD OF PUBLIC WORKS  
WATER DIVISION

Sketch of Service Here

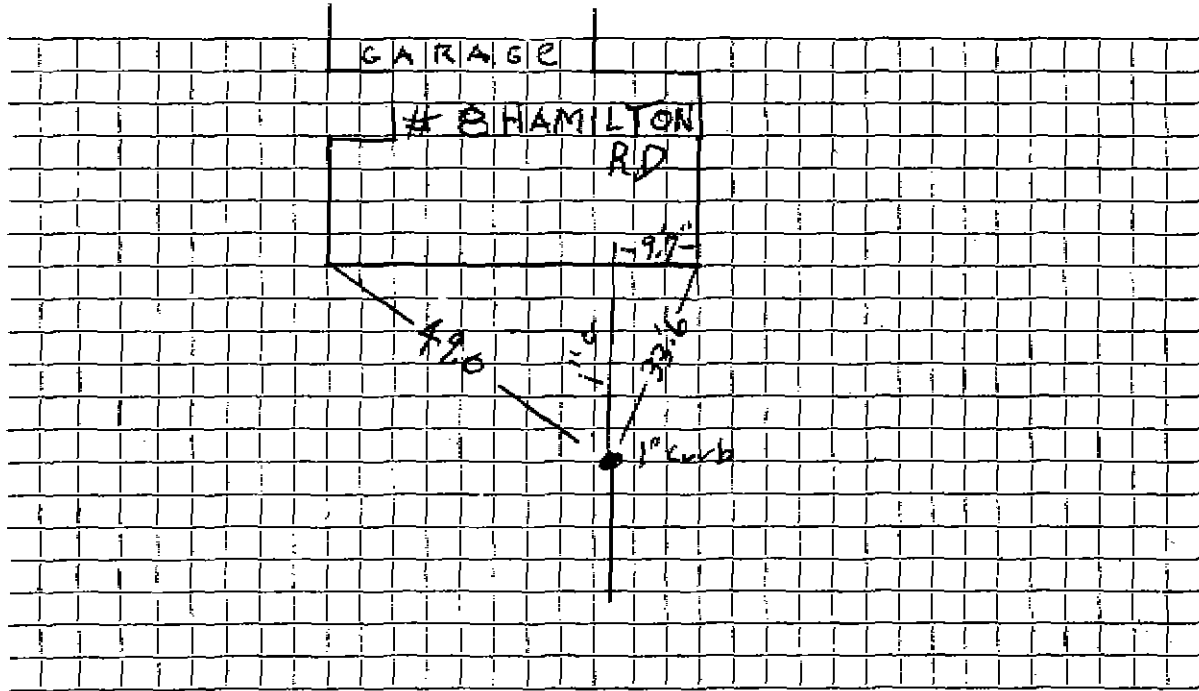

Connection made in ..... Street.

Work completed 11/24/04 J. McLaughlin

Remarks: .....  
.....  
.....