

## WATER SERVICE RECORD

Name Donald M. Hampton

Service No. 101

Address 9 Hamilton Road

Location

# 9355  
# 682~~Repairs General~~ - New Service


Comm. 10-8-56

| Date    | Material                                    | Amount | Total | Date                                 | Amount           |
|---------|---|--------|-------|--------------------------------------|------------------|
| 6/21/56 | Labor                                       | 1 90   |       | 5-15-56                              | Deposit 50 00    |
| 6/22/56 | "   | 1 90   |       | 10-8-56                              | Refund 11 01     |
|         |   | 3 80   |       |                                      | NON CHARGE 38 99 |
|         | 10% overhead                                | 38     | 4 18  | 6/21/56                              | Labor 1 90       |
|         | 60' - 3/4" Copper tubing @ .4850            | 29 10  |       | 27' - 3/4" Copper tubing @ .4850     | 13 10            |
|         | 1 - 3/4Cx $\frac{1}{2}$ I.W.H. Stop & Waste | 4 96   |       | 1 - 3/4" C. Corp Cock                | 4 64             |
|         | 1 hr. trucking                              |        | 75    | 1 - 3/4" C. Curb Cock                | 5 94             |
|         |   |        | 38 99 | 1 Box & Rod                          | 4 62             |
|         |   |        |       | 1 - $\frac{1}{2}$ Straight tailpiece | 50               |
|         |   |        |       | 1 - $\frac{1}{2}$ Offset Tailpiece   | 50               |
|         |   |        |       |                                      | <u>31 20</u>     |

TOWN OF LEXINGTON — BOARD OF PUBLIC WORKS

WATER DIVISION

Sketch of Service Here

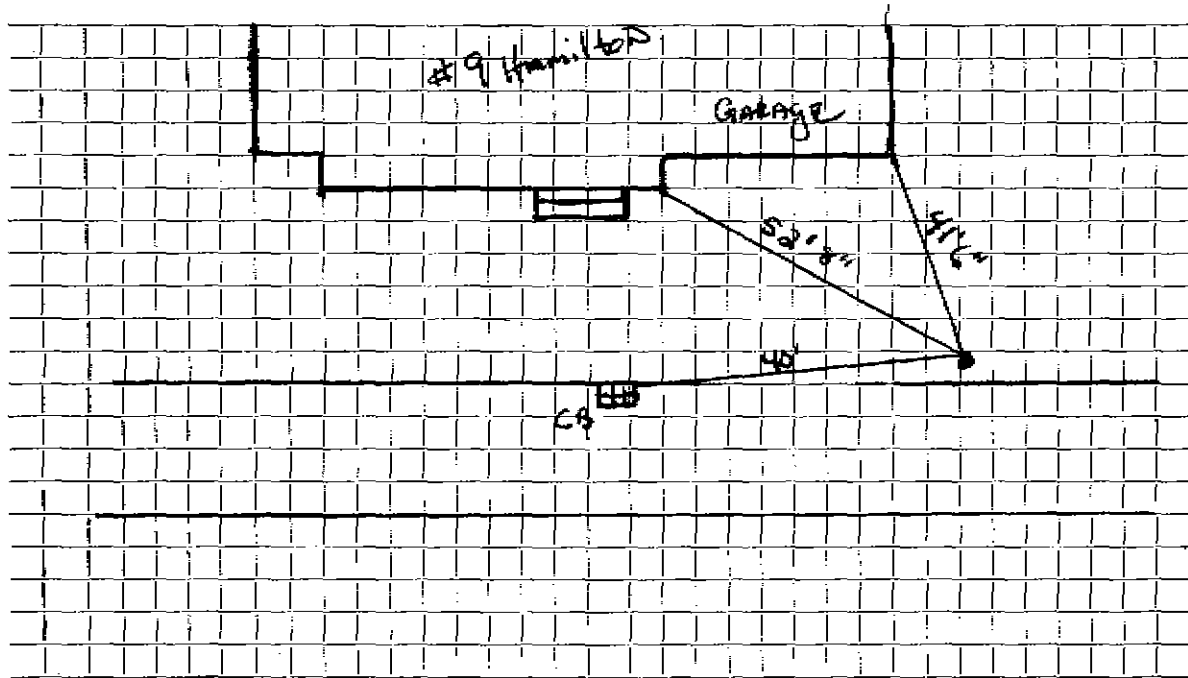

Connection made in ..... Street. Work completed .....

Remarks: .....  
.....  
.....