




acg

DATE \_\_\_\_\_

# TOWN OF LEXINGTON — BOARD OF PUBLIC WORKS WATER DIVISION

Sketch of Service Here

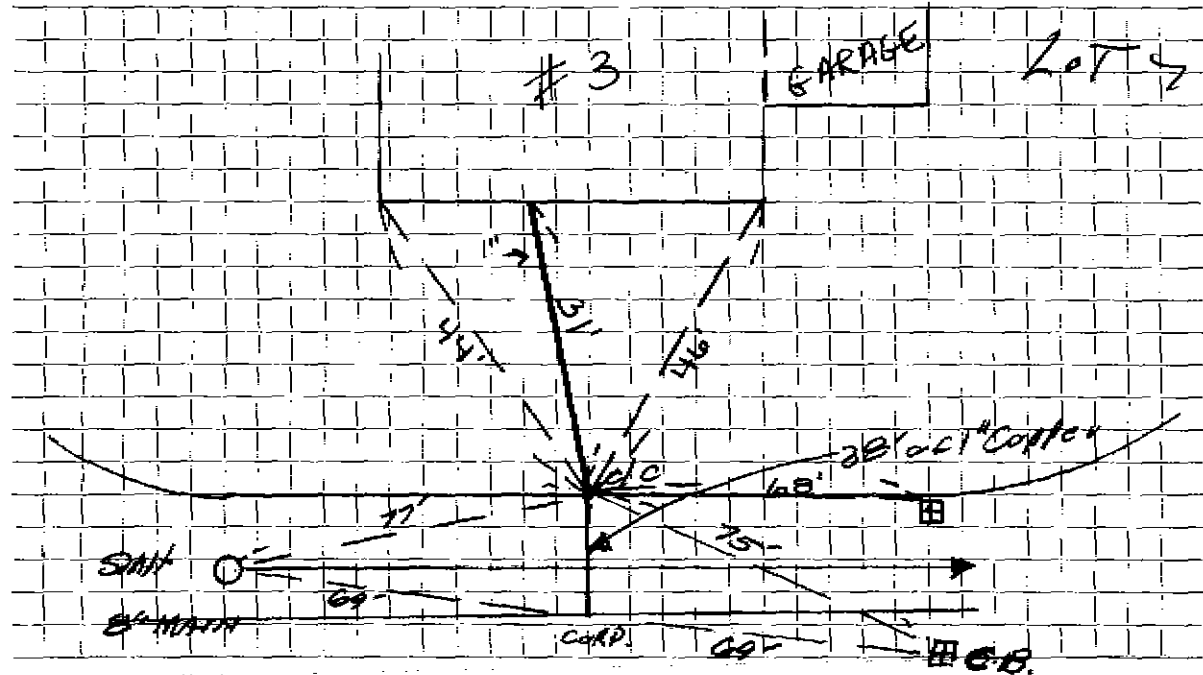

Connection made in HAMPTON RD. Street. Work completed .....

Remarks: .....  
.....  
.....