

WATER SERVICE RECORD

Name

Service No.

Address

27 Hampton Rd.

Location

lot 5


Repair—Renewal—New Service

Date	Material	Amount	Total	Date	Amount
9/12/85	33' of 1" Copper N.C. 1" VALVE			11/4/86	
				33' 1" COPPER	
				1" CURB	
				1" COPP	
				Bolt Rod	

TOWN OF LEXINGTON — BOARD OF PUBLIC WORKS

WATER DIVISION

Sketch of Service Here

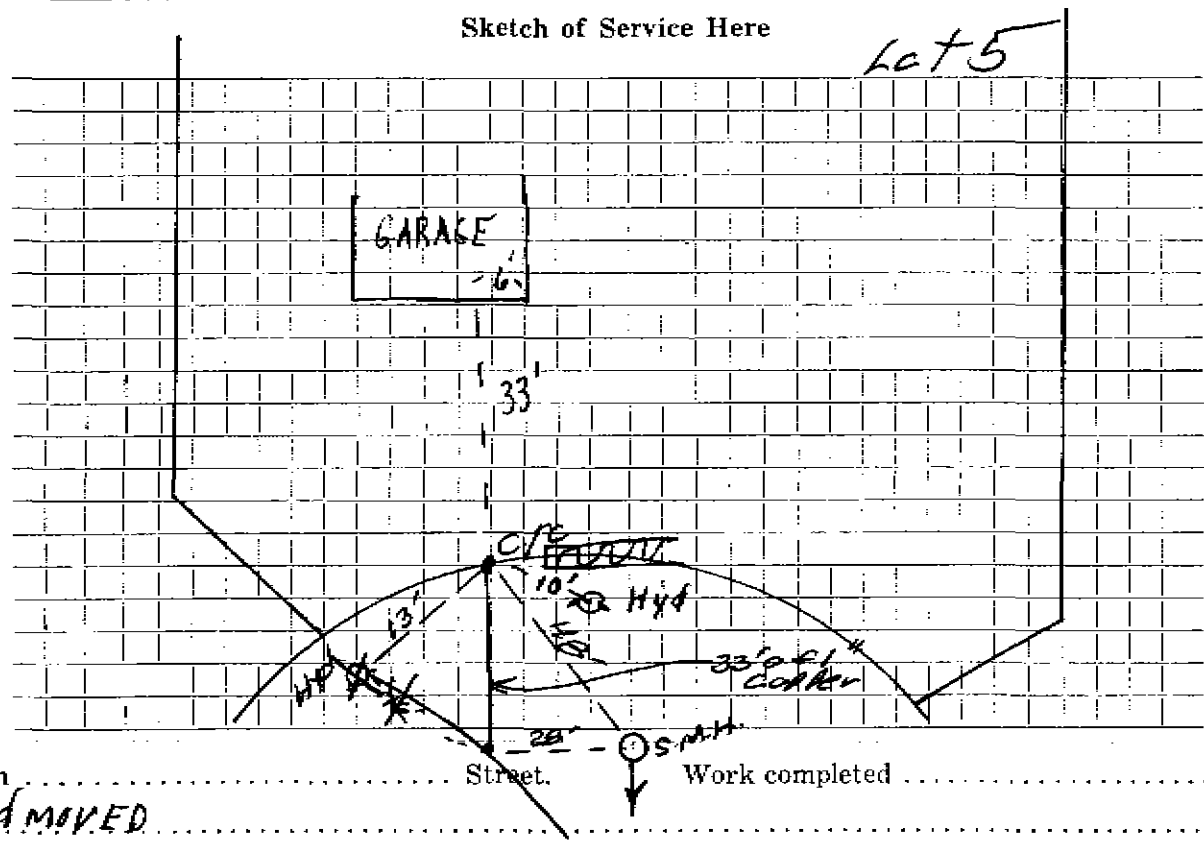

Connection made in _____ Street. Work completed _____

Remarks: Hyd MOVED