


DATE _____

TOWN OF LEXINGTON — BOARD OF PUBLIC WORKS

WATER DIVISION

Sketch of Service Here

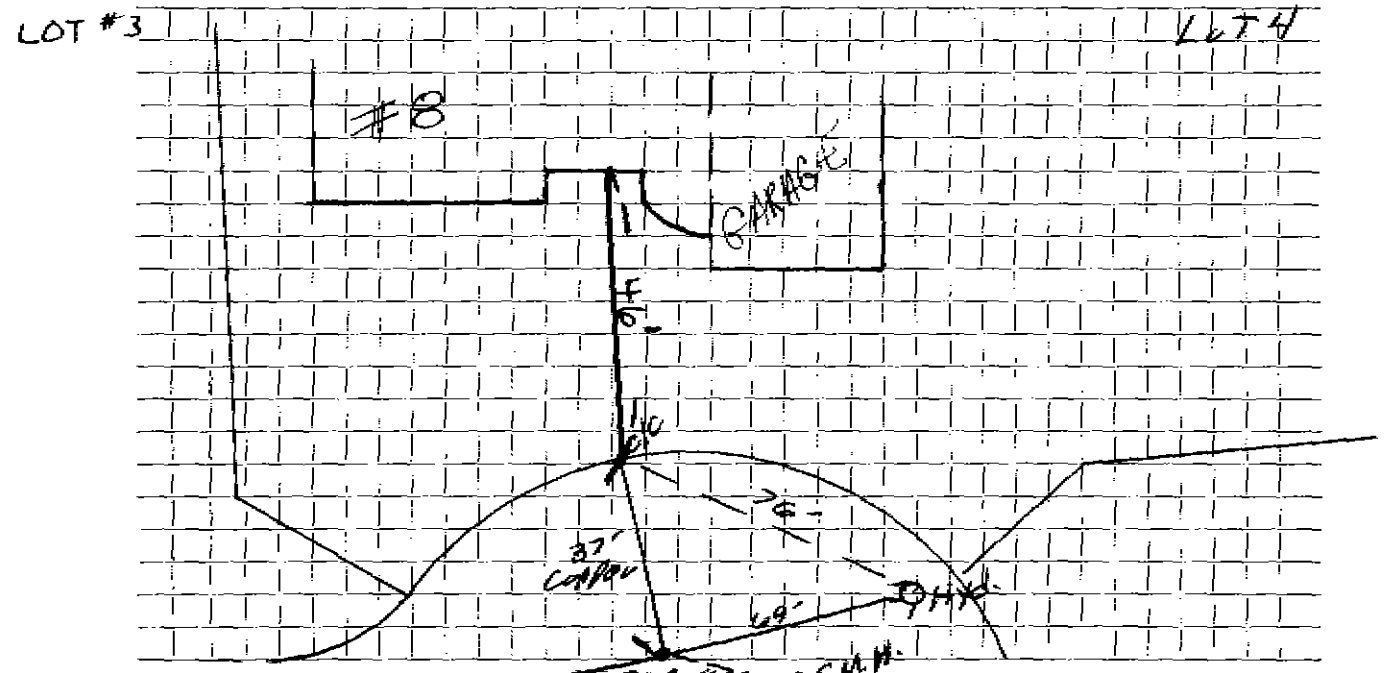

Connection made in HAMPTON RD Street. Work completed 5 A.M.

Remarks:

.....

.....