

WATER SERVICE RECORD

Name

Service No.

Address 12 HANCOCK AVE.

Location

Repair—Renewal—New Service CSP & SONS #A1-10

Date	Amount	Total	Date	Amount
10-22-92			5-30-96	

OUTSIDE

10-22-92

*17 LF 1" COPPER
1" COPP.
1" CURB W/RED.*

5-30-96


*29' 3/4 COPPER
3/4 x 1/2 S-W*

DATE _____

TOWN OF LEXINGTON — BOARD OF PUBLIC WORKS

WATER DIVISION

Sketch of Service Here

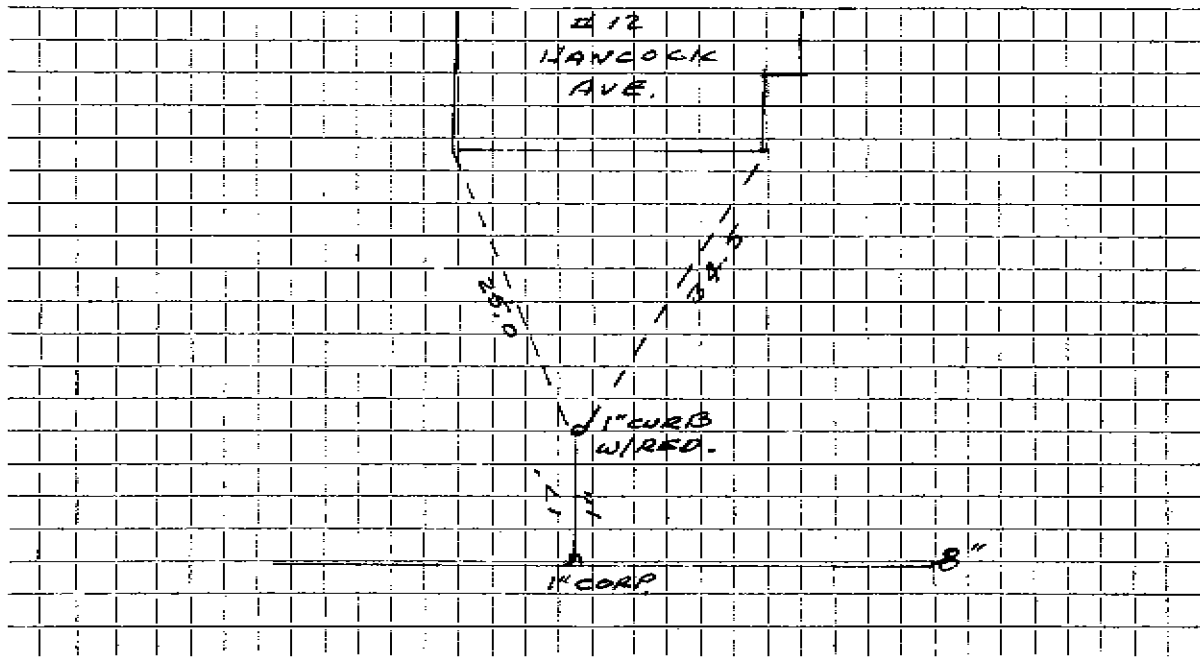

Connection made in HANCOCK AVE. Street. Work completed

Remarks: INSIDE SERV. 3/4"

.....
.....