


DATE _____

TOWN OF LEXINGTON — BOARD OF PUBLIC WORKS
WATER DIVISION

Sketch of Service Here

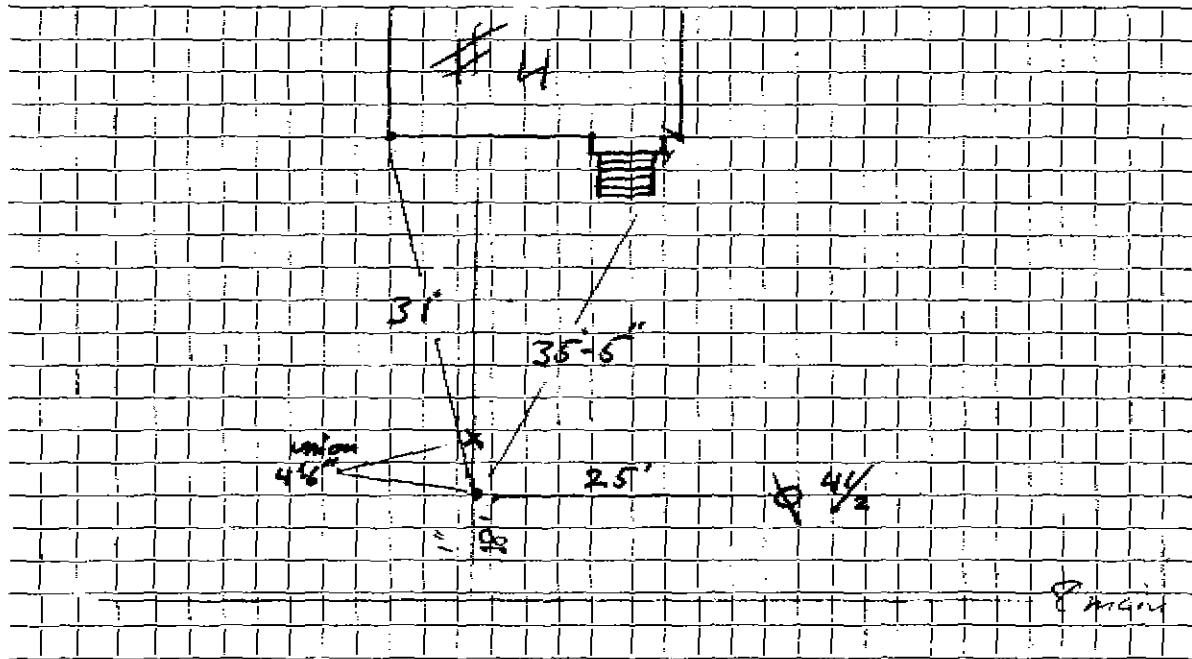

Connection made in Hancock Ave. Street. Work completed

Remarks: 3/4" in side 1" at side