




DATE \_\_\_\_\_

# TOWN OF LEXINGTON — BOARD OF PUBLIC WORKS

## WATER DIVISION

Sketch of Service Here

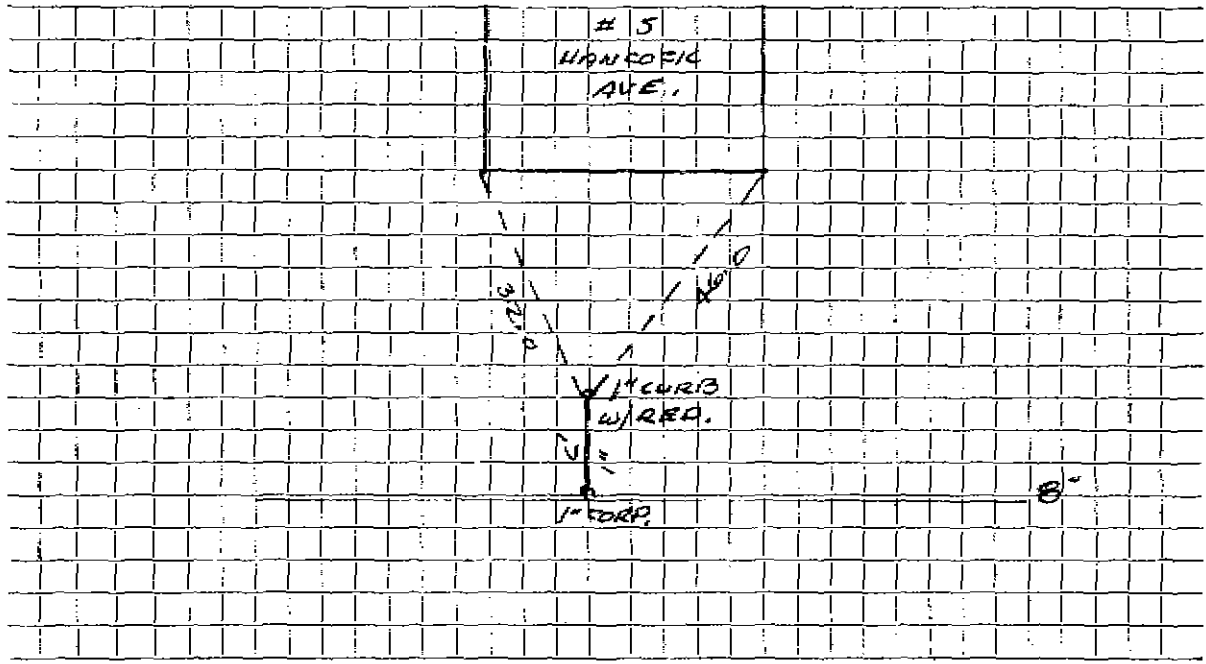

Connection made in LIANCOEK AVE. Street. Work completed .....

Remarks: INSIDE SERV. 3/4"  
.....  
.....