




DATE \_\_\_\_\_

TOWN OF LEXINGTON — BOARD OF PUBLIC WORKS

WATER DIVISION

Sketch of Service Here

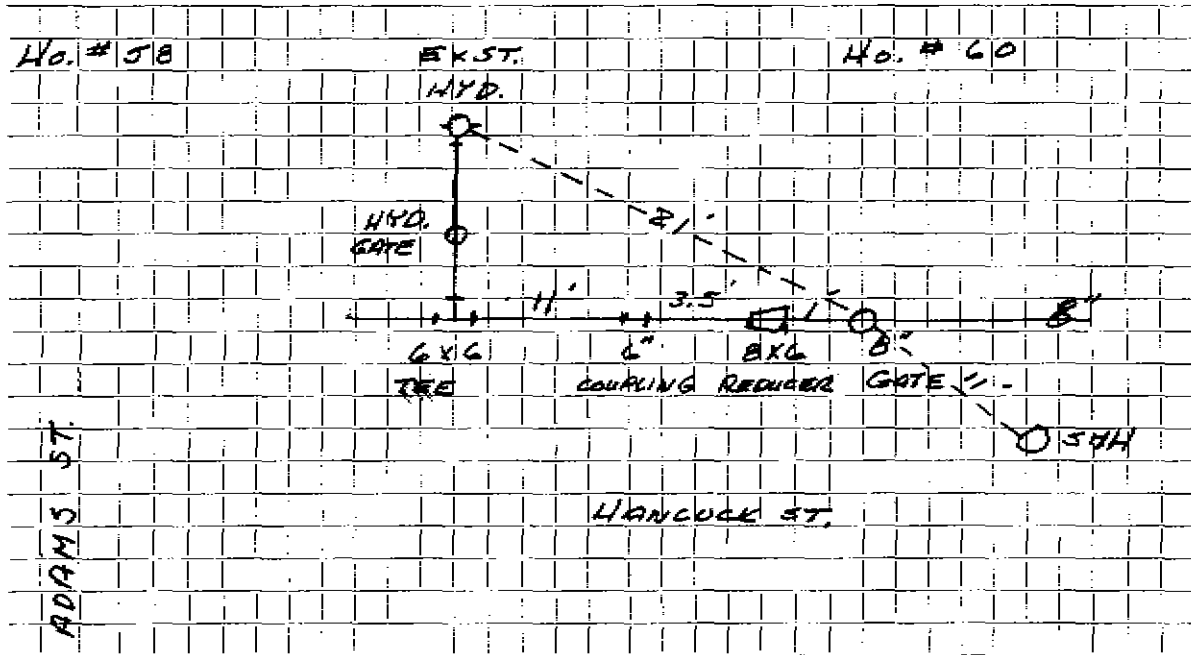

Connection made in HANCOCK Street. Work completed .....

Remarks: TIE IN OF NEW 8" D.I. & EXST. 6" C.I. .....

LAL - CONTRACTOR .....