




DATE \_\_\_\_\_

TOWN OF LEXINGTON — BOARD OF PUBLIC WORKS

**WATER DIVISION**

Sketch of Service Here

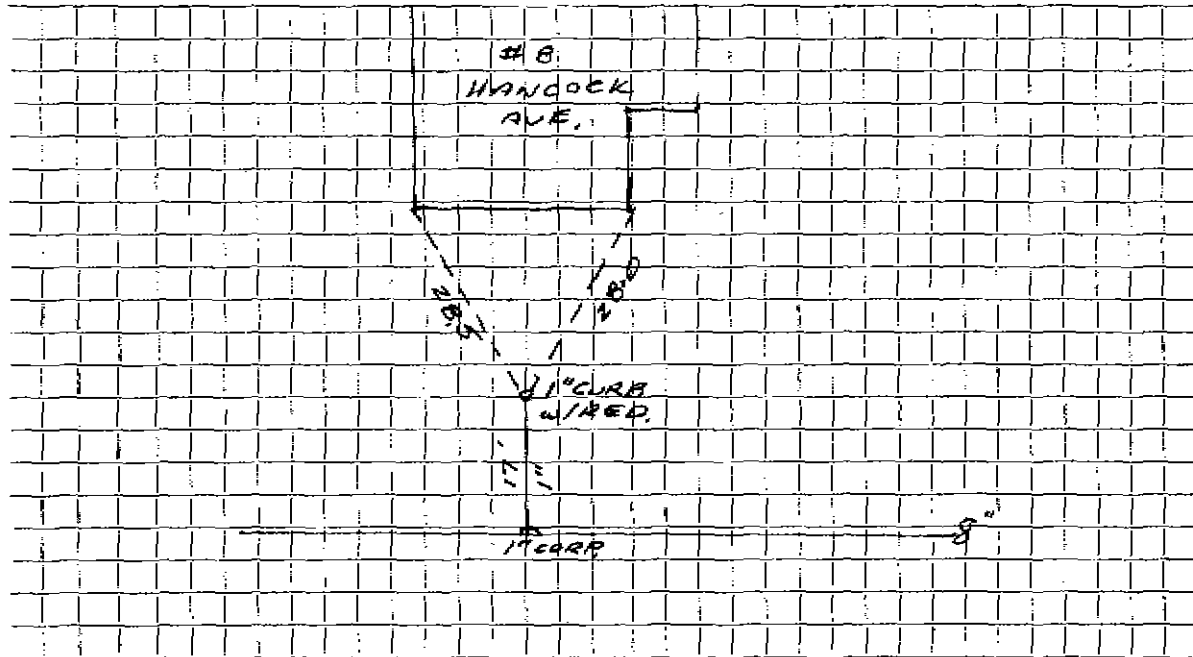

Connection made in HANCOCK AVE. Street. Work completed .....

Remarks: INSIDE SERV. 3/4" .....

.....  
.....