

WATER SERVICE RECORD

Name NEW HYDRANT

Service No.

Address

Location HANCOCK ST.


Repair—Renewal—New Service

DATE _____

TOWN OF LEXINGTON — BOARD OF PUBLIC WORKS

WATER DIVISION

Sketch of Service Here

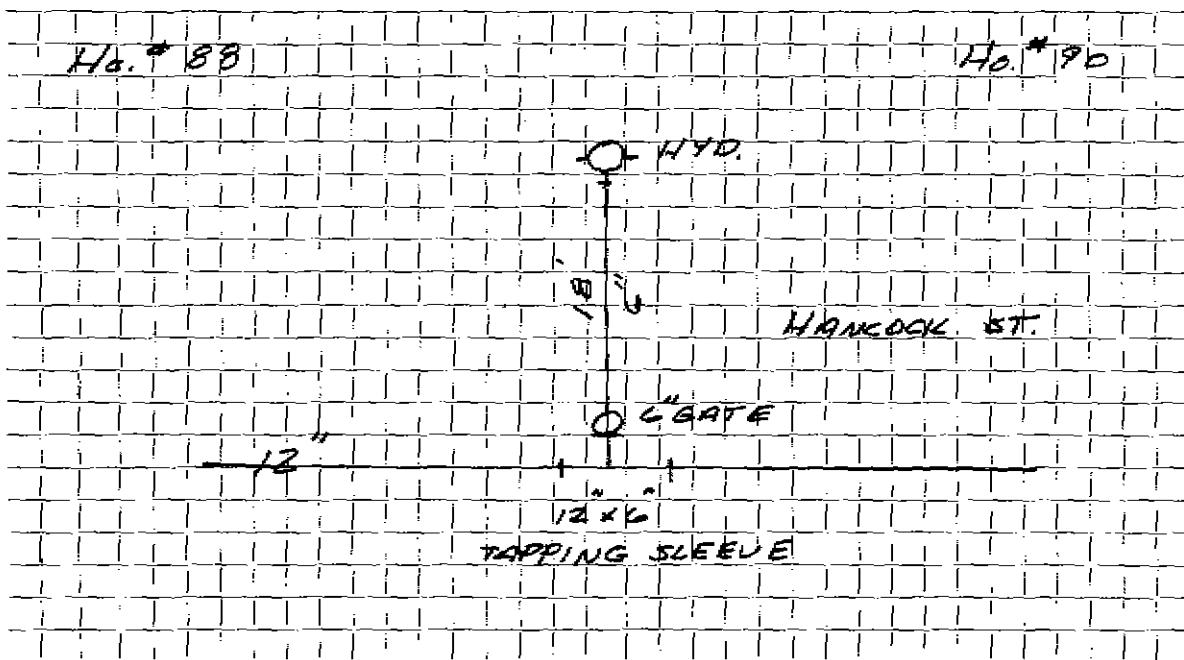

Connection made in HANCOCK Street. Work completed _____

Remarks: _____