


DATE _____

TOWN OF LEXINGTON — BOARD OF PUBLIC WORKS

WATER DIVISION

Sketch of Service Here

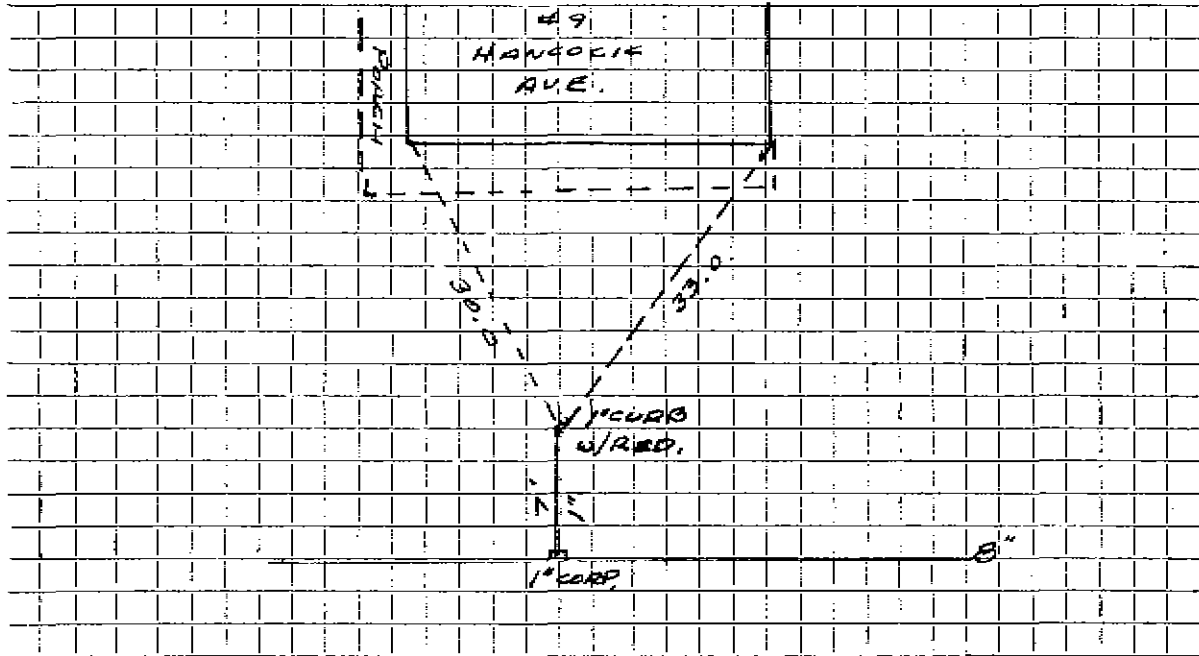

Connection made in HANCOCK AVE. Street. Work completed

Remarks: INSIDE SERV. 3/4"