WATER	SERVICE	RECORD		

Service No.

Name NEW HYDRANT Address

Location HANCOCK ST.

Repair-Renewal-New Service


	-MenewalIvew Selvace			-		
Date	Material	Amount	Total	Date		Amount
6-18-86	HYDRANT					
	IZXG TAPPING					
<u>-</u>	SLEEVE & GATE		İ			
	12.7'-6" D. I.					
<u> </u>	! 		: 	- - -		
! 			<u> </u>			<u> </u>
					·	
- !	!	_	·	"	į	
	1					
				"		
	·		_			
				· · ·		
- - :- 						
-						
						\
	<u> </u>					
		 + 	 	1		
!	i			, ,		* 1

DA	TF _			
	-	 	 	_

TOWN OF LEXINGTON - BOARD OF PUBLIC WORKS

WATER DIVISION

Sketch of Service Here

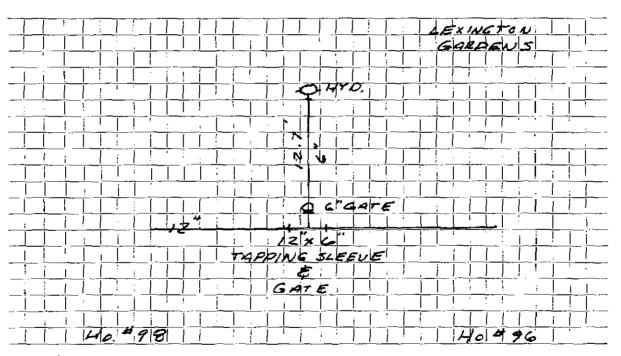

Connection made in	Work completed
Remarks:	