


TOWN OF LEXINGTON — BOARD OF PUBLIC WORKS

WATER DIVISION

Sketch of Service Here

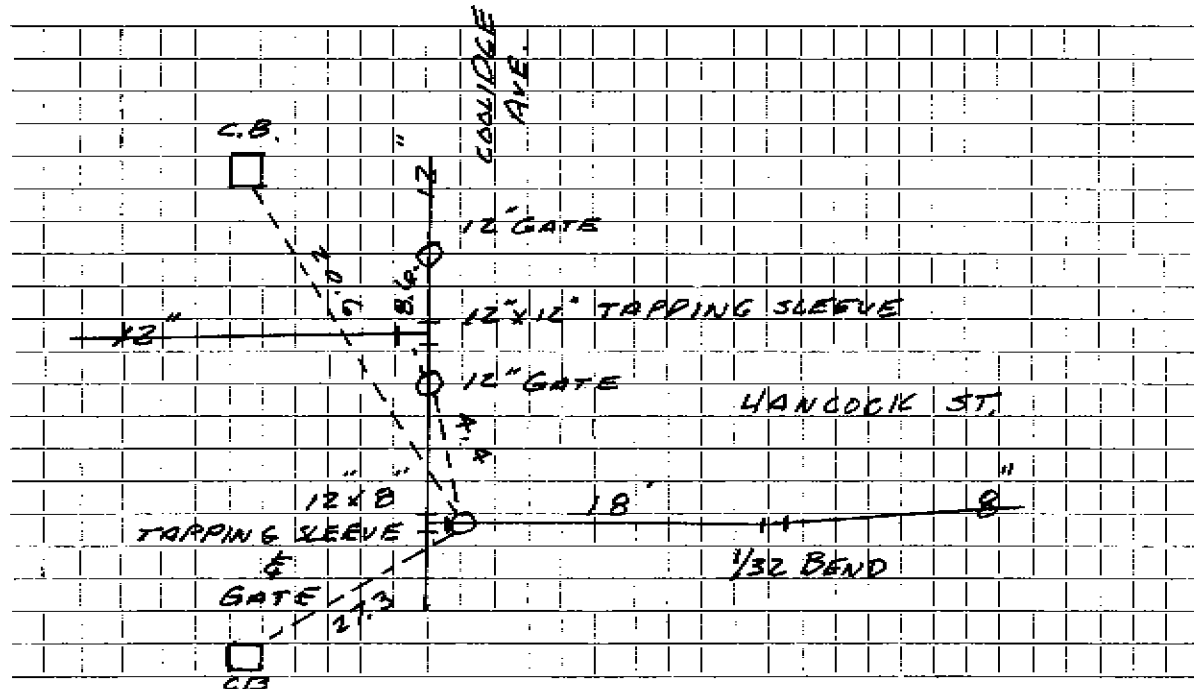

Connection made in HANCOCK Street. Work completed

Remarks: ABANDON 6" CI. ADAMS - BURLINGTON ST.