

## WATER SERVICE RECORD

Name Joseph Aronson

Service No.

Address 100 Hancock Street


Location

~~Repair~~—Renewal ~~XXXXXXXX~~ Eagle #3711

Date	Material	Amount	Total	Date	Material	Amount
7/1/81	27' 3/4" Copper tubing					
	1 3/4 x 3/4 Stop & waste					
					OUTSIDE	
				7/1/81	16' 3/4" Copper tubing	
					1 3/4" Corp.	
					1 3/4" Curb Stop	
					1 Box & Rod	

TOWN OF LEXINGTON — BOARD OF PUBLIC WORKS  
WATER DIVISION

Sketch of Service Here

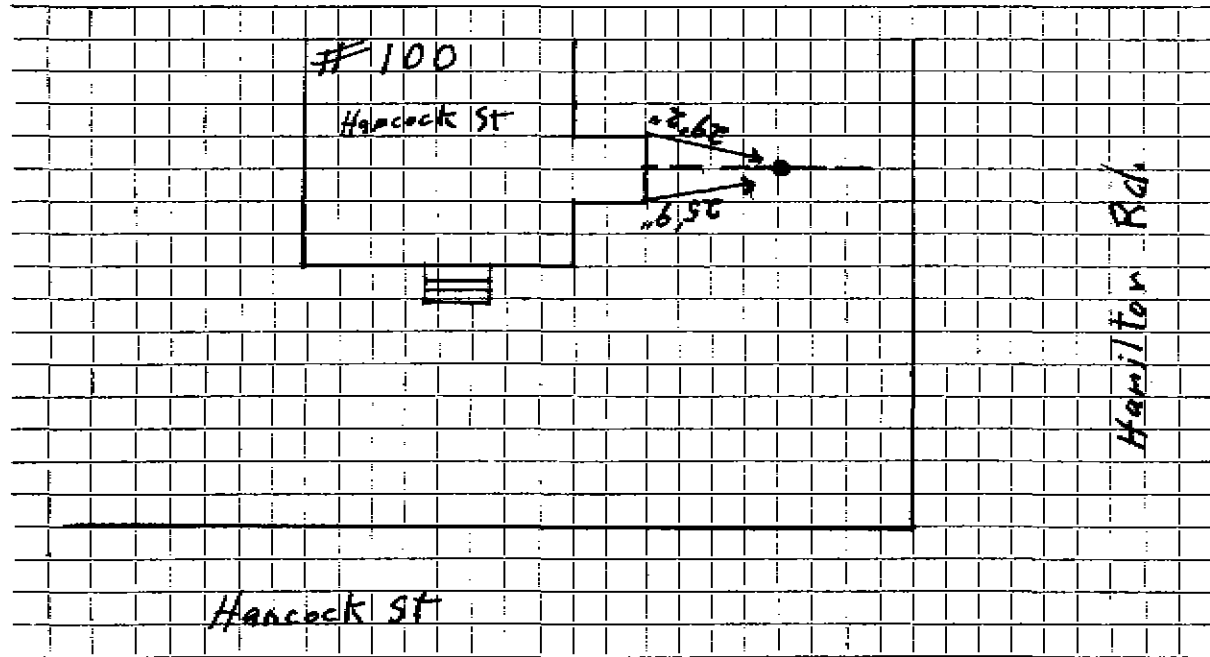

Connection made in Hamilton rd. Street. Work completed .....

Remarks: .....  
.....  
.....