


TOWN OF LEXINGTON — BOARD OF PUBLIC WORKS

WATER DIVISION

Sketch of Service Here

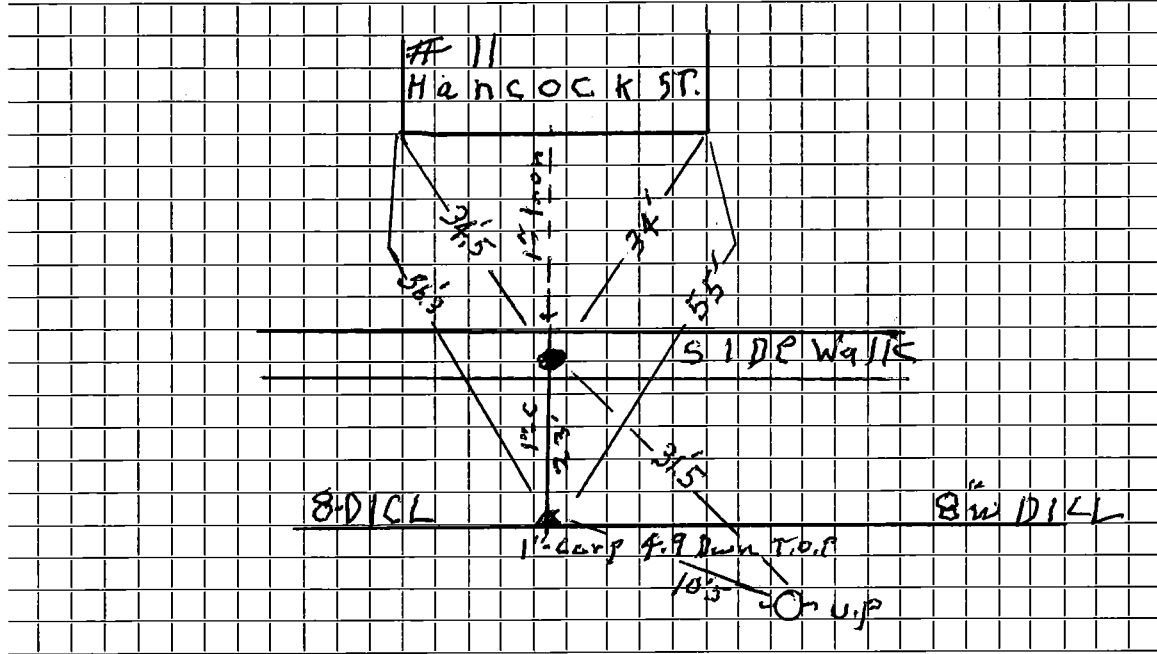

Connection made in Hancock St. Street. Work completed 7/27/17 Defective

Remarks: 1" Iron To house

.....
.....