

WATER SERVICE RECORD

Name Robert Seaman

Service No. 63

Address 17 Hancock Street

Location

~~Repair~~ Renewal ~~New Service~~ W. O. # 92

DEC 18 1972


Date	Material	Amount	Total	Date	Amount
9/20/72	Labor	56 76		9-20-72	Deposit 300 00
	10% O.H.	5 68	62 44	12-18-72	Refund 71 41
38'	1" Copper pipe .99		37 62		128 59
XX	1"x3/4" Stop & Waste		12 53		
	1-Hr. Trucking		3 00		<u>OUTSIDE</u>
	2-Hrs. Shovel 6.50		13 00	9/20/72	Labor 56 76
			128 59	28'	Copper pipe .99 27 22
					1" Corporation 10 66
					1 Curb Stop 14 43
					Box & Rod 7 50
				1	Hr. Trucking 3 00
				2	Hrs. Shovel XXXXX 4.00 8 00
					<u>127 57</u>

DATE _____

TOWN OF LEXINGTON — BOARD OF PUBLIC WORKS

WATER DIVISION

Sketch of Service Here

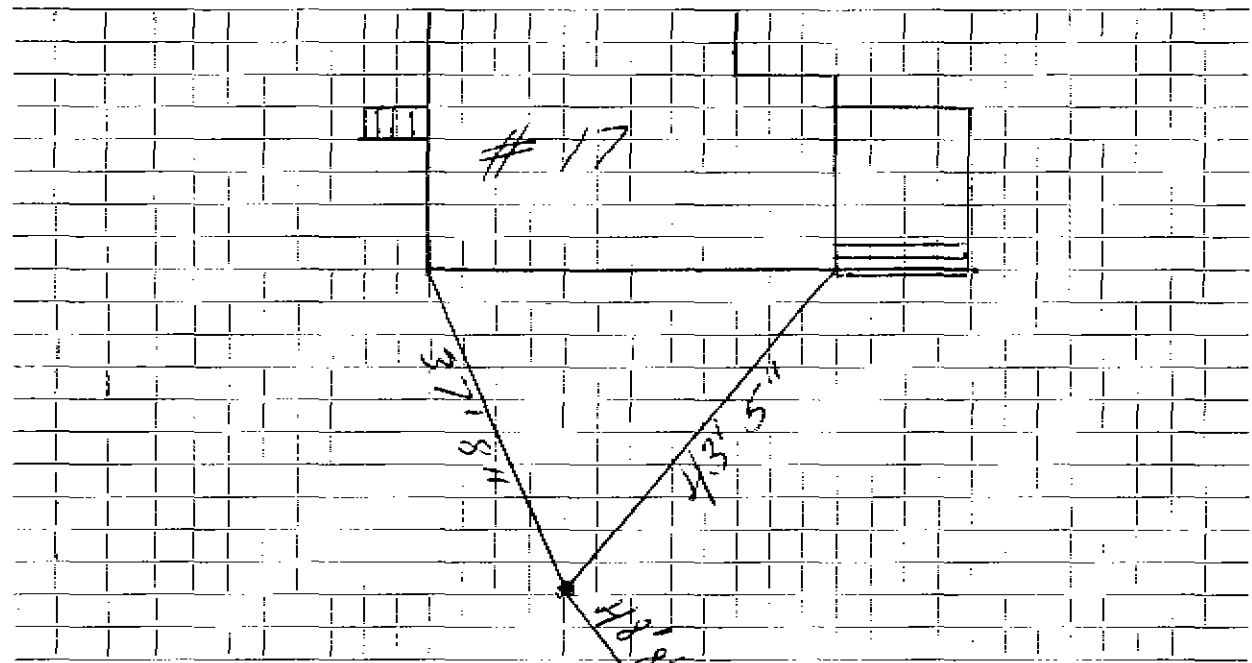

Connection made in Street. Work completed

Remarks:

.....
.....