

WATER SERVICE RECORD

Name Jean S. Baxter

Service No. 251

Address 18 Hancock Street

Location

~~REPAIR~~ - Renewal - ~~NEW SERVICE~~

*Comm 12-13-54*


Date	Material	Amount	Total	Date	Amount
10/27/54	Labor	10 10		10-6-54	Deposited 45 00
	10% overhead	1 01	11 11	12-13-54	Refunded (9 74)
	34' - 3/4" copper tubing@ .35	11 90			<u>NON CHARGE</u> 35 26
	1 - 3/4" C x 3/8 I.W.H. stop & waste	4 00		10/27/54	Labor 10 10
	1 hr. Littlefield shovel	7 50			7' - 3/4" copper tubing@ .35 2 45
	1 hr. trucking	75			1 - 3/4" C. adapter 1 95
		35 26			1 - 3/4" C. curb-cock 4 67
	PART OF TRENCH DUG BY OWNER:				1 box and rod 3 90
					1 - 1/2 offset tail pc. 50
					1 - 1/2 straight tail pc. 50
					1 hr. Littlefield shovel 7 50
					1 hr. trucking 75
					<u>32 32</u>

DATE \_\_\_\_\_

TOWN OF LEXINGTON — BOARD OF PUBLIC WORKS

**WATER DIVISION**

Sketch of Service Here

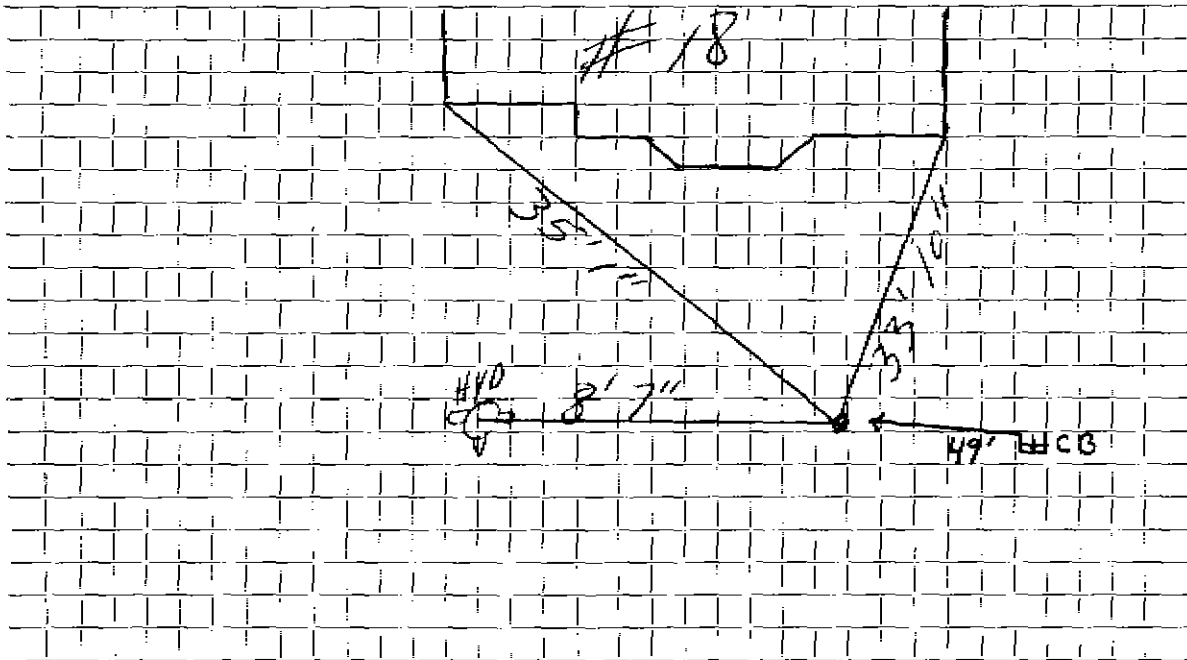

Connection made in ..... Street. Work completed .....

Remarks: .....  
.....  
.....