

WATER SERVICE RECORD

# 4720

Name

Service No.

Address 19 Hancock Street

Location


~~REPAIR~~ Renewal ~~REPAIR~~

Date	Material	Amount	Total	Date	Amount
1/21/99	PHD CONNECTION				
EMERGENCY 3/4	COPPER				
DONE SAT					
NO INSP.					
					NON CHARGE
				8-16-63	Labor 59.39
					34' 1" Copper tubing @.56 19.04
					1 1" Copper <del>ELBOW</del> Adapter 3.29
					2 1" Curb Cocks @8.06 16.12
					1 Box & Rod 4.90
					2 hrs. Town Shovel @6.50 13.00
					1 hr. Trucking @3.00 3.00
					<u>118.74</u>

DATE \_\_\_\_\_

**TOWN OF LEXINGTON — BOARD OF PUBLIC WORKS**  
**WATER DIVISION**

Sketch of Service Here

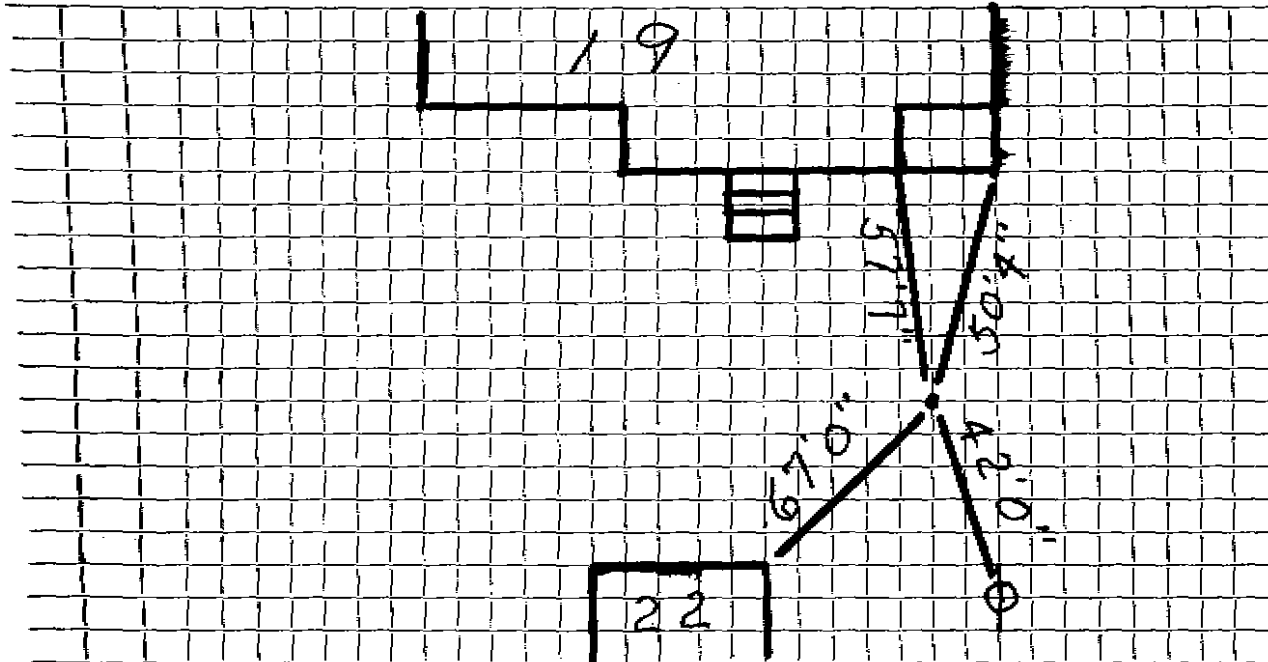

Connection made in ..... Street. Work completed .....

Remarks: .....  
.....  
.....