

Name John W. Wallen

Service No. ~~30~~ 1134

Address 50 Florence Ave., Arlington
21 Hancock St.

Location 21 Hancock Street (Lot #6)

Kind of Pipe

Size

Size of Main

~~Repair-Renewal~~ New Service

Location

Date

Material

Amount

Total

Date

Amount

11/22/33

Estimated cost of
service, 42' @ .45

\$18 90

Nov. 7, 1933

18 90

1" Copper

Labor

DATE

Mar. 7, 1933

TOWN OF LEXINGTON—BOARD OF PUBLIC WORKS

WATER DIVISION

Lot # 6

The undersigned applies for a supply of water at No. 21 Hammond St. and hereby agrees to comply with the rules and regulations as now, or at any future time, established by the Board of Selectmen.

Am't. of Estimate \$ 18.00

Owner

John H. Wallen

Am't. Paid \$ _____


Address

50 Florence Ave. Arlington

Builder

H. Tobiasson

Sketch of Service Here

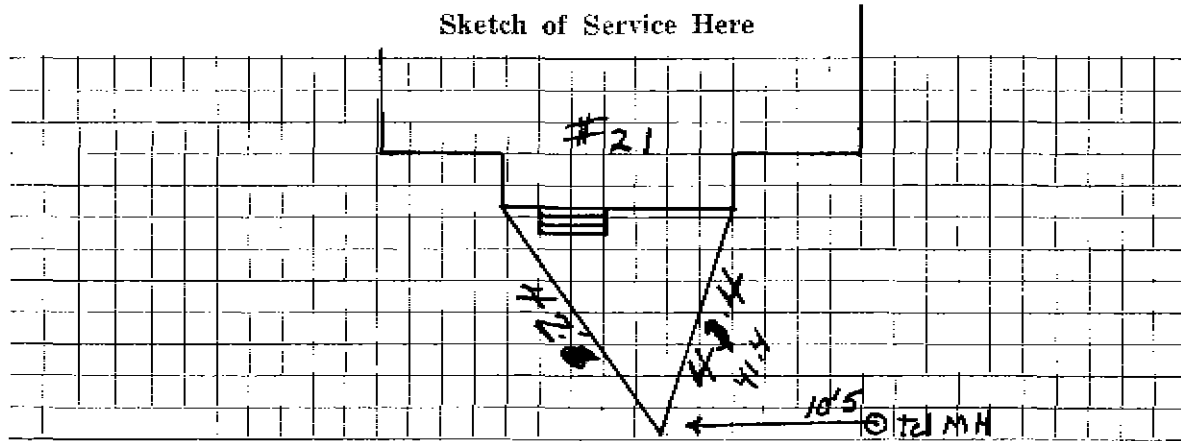

Connection made in _____ Street.

Work completed _____ 19

Remarks: