

WATER SERVICE RECORD JUL 24 1978

Name Walter H. Bergler

Service No. 14

Address 22 Hancock Street

Location


~~Repair~~—Renewal—~~New Service~~ W.O. #6403 *X 20034*

Date	Material	Amount	Total	Date	Amount
6/20/78	Labor	144.78		6-30-78	Deposit 250.00
	10% O.H.	14.48	159.26	9-24-78	Refund 28.54
	40' 3/4" Copper tubing @.74		29.60		226.46
	1 3/4" Wheel handle		17.10		OUTSIDE
	2 5/8 Tail pieces		2.00	6/20/78; 7/20/78	labor
	1 3/4" x 1/2" Reducing Bushing		1.56		7' X 8' long hot patch
	1/2 yd. Loam		2.72	3	hrs. trucking
	3 lbs. Seed @.74		2.22	1	hr. comp.
	1/2 bag Line		.50	1	hr. roller
	1/2 bag Fertilizer		2.00		3 3/4" Copper
	1 hr. Trucking		3.00		1 3/4" CURB COCK
	1 hr. Backhoe		6.50		
			226.46		

DATE _____

TOWN OF LEXINGTON — BOARD OF PUBLIC WORKS
WATER DIVISION

Sketch of Service Here

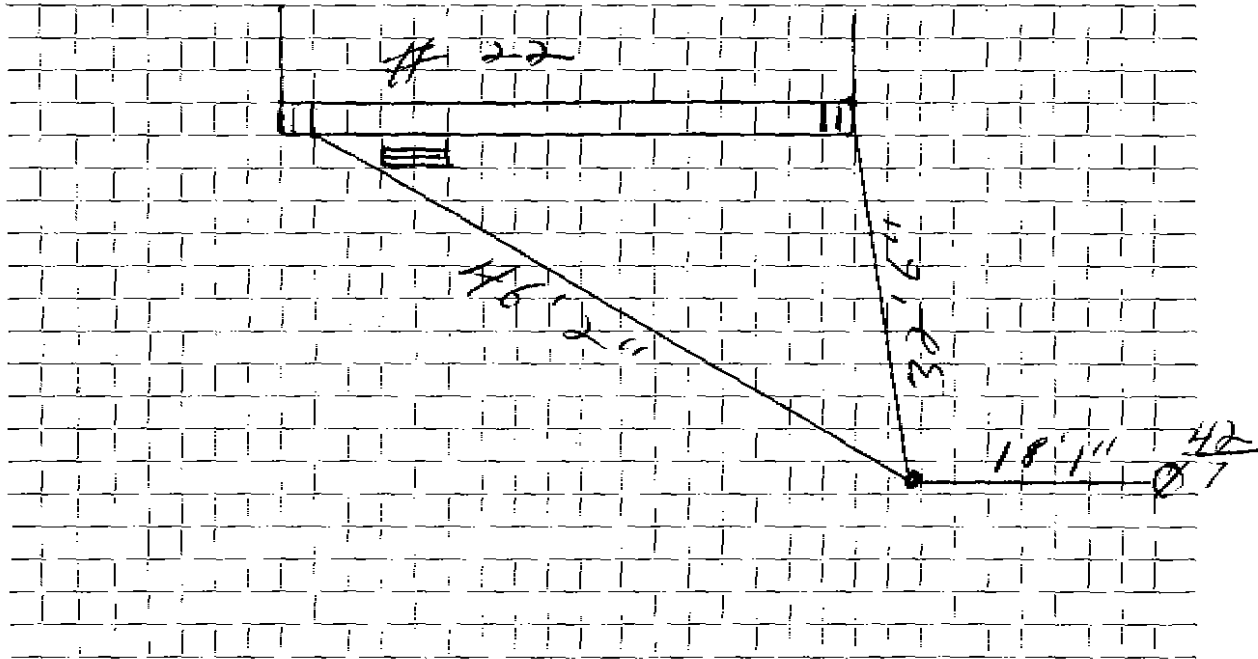

Connection made in Street. Work completed

Remarks:

.....

.....