

WATER SERVICE RECORD

Name Leslie H. York

Service No. 233

Address 24 Hancock Street

Location

Command. 11-19-56

~~Repair~~ - Renewal ~~Work~~ Service

Date	Material	Amount	Total	Date	Amount
8/16/56	Labor	5 70		8-3-56	Deposit 50 00
	10% overhead	57	6 27	11-19-56	Refund * 17 16
	43' - 3/4" Copper tubing @ .4850	20 86			NON CHARGE 32 54
	1 - 3/4Cx 1/2 I.W.H. Stop & Waste	4 96		8/16/56	Labor 3 80
	1 hr. trucking		75		8' - 3/4" Copper tubing @ .4850 3 88
			32.84		1 - 3/4" C. Corp Cock 4 64
					1 - 3/4" C. Curb Cock 5 94
					1 Box & Rod 4 62
					1 - 1/2 Straight tailpiece 50
					1 - 1/2 Offset tailpiece 50
					<u>23 88</u>


\* \$13.52 applied to S.H.C. #105

DATE \_\_\_\_\_

TOWN OF LEXINGTON — BOARD OF PUBLIC WORKS

**WATER DIVISION**

Sketch of Service Here

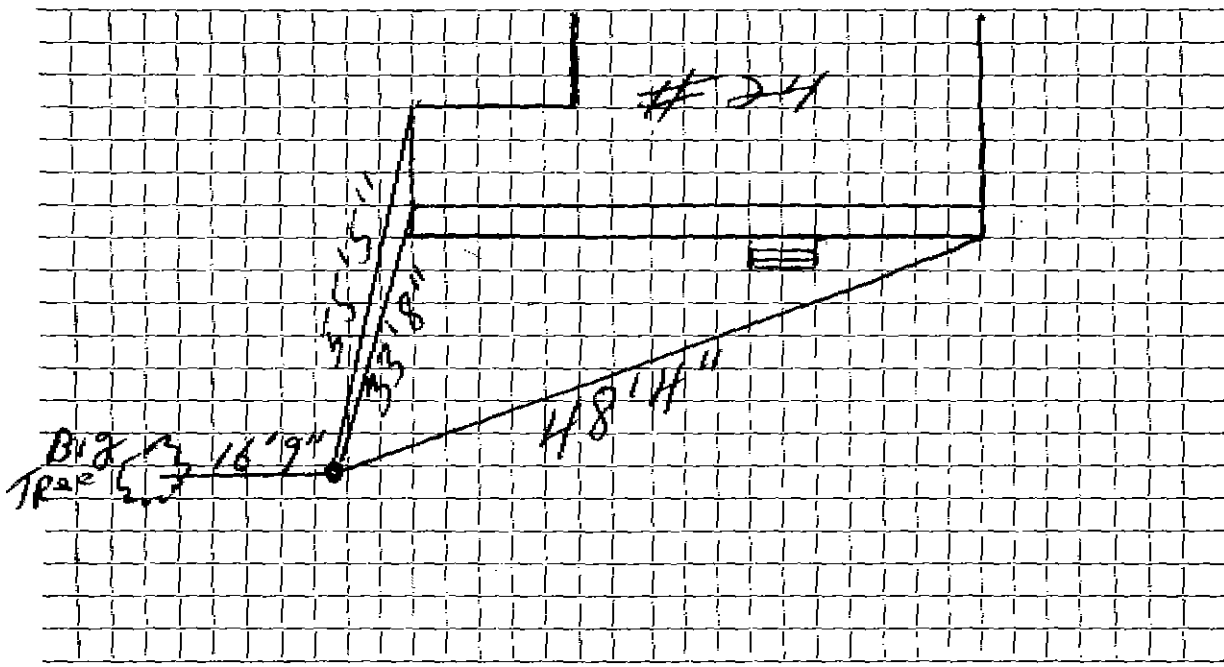

Connection made in ..... Street. Work completed .....

Remarks: .....  
.....  
.....