

WATER SERVICE RECORD

4758

Name Kenneth Brook

Service No. 53

Address 26 Hancock Street

Location

~~Repair~~ - Renewal - ~~New Service~~ No. O. # 10

DEC 18 1972


| Date | Material | Amount | Total | Date | Amount |
|--------|-----------------------------------|--------|--------|----------|--------------------|
| 9/6/72 | Labor | 60 33 | | 8-29-72 | 150 00 |
| | 10% O.H. | 6 03 | 66 36 | 12-18-72 | 35 55 |
| 24' | 1" Copper pipe .99 | | 23 76 | | 114 78 |
| 1 | 1" Stop & Waste | | 12 53 | | |
| | 1"x3/4" Brass (coupling) coupling | | 1 42 | 9/6/72 | <u>OUTSIDE</u> |
| | 3/4"x1/2" Brass bushing | | 1 21 | | Labor |
| | 1-Hr. Trucking | | 3 00 | | 7' Copper pipe .99 |
| | 1-Hr. Shov | | 6 50 | | 1" Corporation |
| | | | 114 78 | | 1 Curb Stop |
| | | | | | Box & Rod |
| | | | | | 1 Hr. Truck |
| | | | | | 1 Hr. Shovel |
| | | | | | 1/2 Ton cold patch |
| | | | | | 129 13 |

DATE _____

TOWN OF LEXINGTON — BOARD OF PUBLIC WORKS

WATER DIVISION

Sketch of Service Here

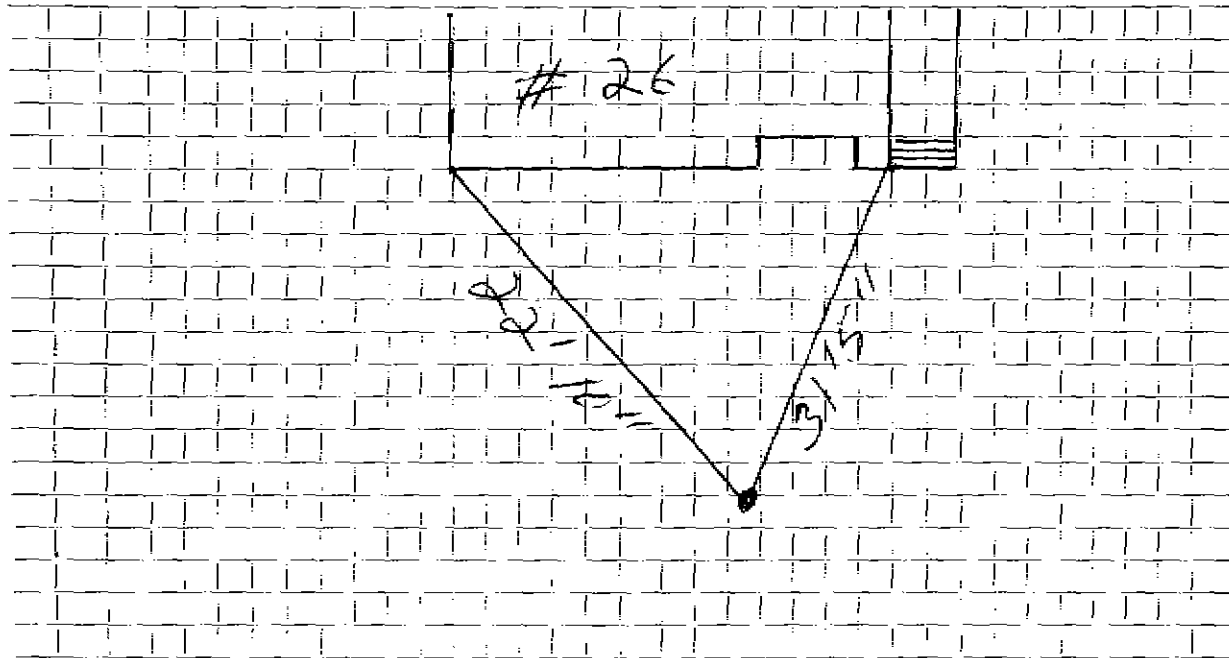

Connection made in Street. Work completed

Remarks:

.....

.....