

WATER SERVICE RECORD

Name Evelyn Phoenix

Service No. 57

Address 27 Hancock Street

Location

~~Repair~~—Renewal—~~New Service~~ W.O. #3832.


MAR 15 1976

Date	Material	Amount	Total	Date	Amount
12/12/75	Labor	\$15.32		12-2-75	Deposit
	10 % O.H.	1.53	\$16.85	3/18/76	Refund
37'	3/4" Copper Tubing @.67		24.79		58.53
1	3/4" Stop & Waste		15.43		NON-CHARGE (Outside) W.O.#3911.
1	3/4" x 1/2" Brass Bushing		1.46	12/15/75	Labor
			\$58.53		\$24.12
				35'	3/4" Copper Tubing @.67
				1	3/4" Corp. Adapter
				1	3/4" Curb Stop
				1	Box & Rod
				1	Hr. Pickup
					1.50
					\$81.72

DATE _____

TOWN OF LEXINGTON — BOARD OF PUBLIC WORKS
WATER DIVISION

Sketch of Service Here

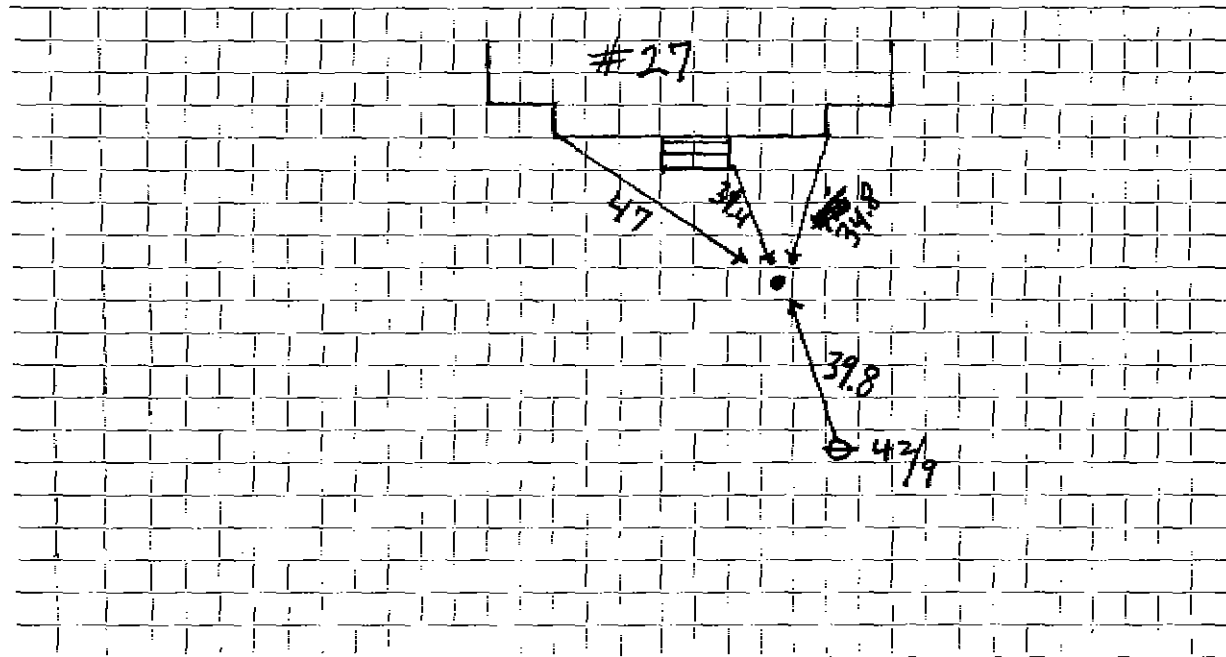

Connection made in Street, Work completed

Remarks:
.....
.....