


DATE 10-18-94

TOWN OF LEXINGTON — BOARD OF PUBLIC WORKS

WATER DIVISION

Sketch of Service Here

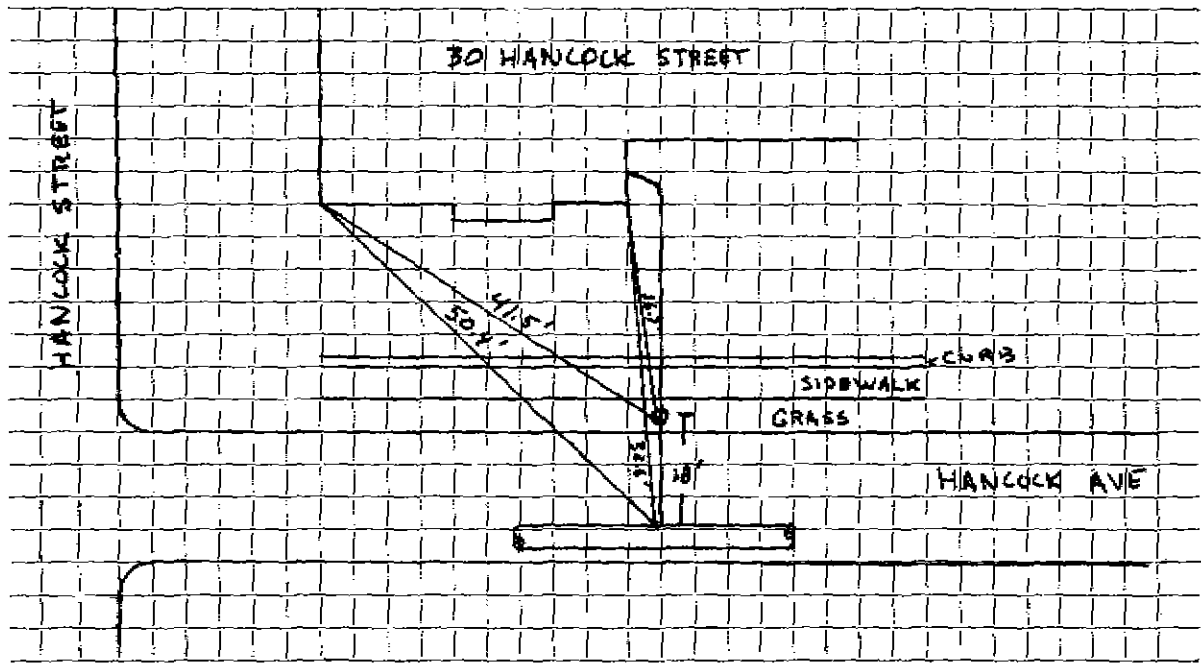

Connection made in ... HANCOCK AVE Street. Work completed

Remarks:
.....
.....